

STATE ENGINEER  
Salem, Oregon

CLAC 00380

# Well Record

STATE WELL NO 1/2 - 32K  
COUNTY CLACKAMAS  
APPLICATION NO. GR-2187

OWNER: Elmer Cassinelli


MAILING ADDRESS: 11619 S. E. Fuller Rd.

LOCATION OF WELL: Owner's No.

CITY AND STATE: Milwaukie, Oregon

NW 1/4 SE 1/4 Sec. 32 T. 1 N. S., R. 2 E. W., W.M.

Bearing and distance from section or subdivision corner S 24° 45' W. 3405'

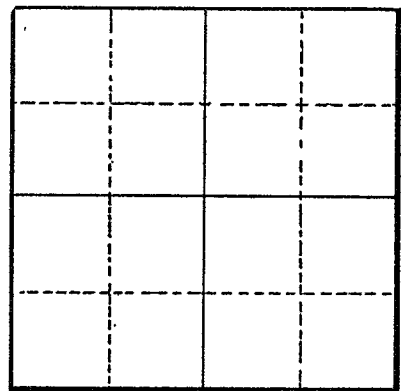

Section

Altitude at well

TYPE OF WELL: Drilled Date Constructed 1930

Depth drilled 104 Depth cased

### CASING RECORD:

6-Inch

### FINISH:

### AQUIFERS:

### WATER LEVEL:

PUMPING EQUIPMENT: Type Pump Jack H.P. 3  
Capacity 30 G.P.M.

### WELL TESTS:

Drawdown ft. after hours G.P.M.  
Drawdown ft. after hours G.P.M.

USE OF WATER Irrigation Temp. °F. 19

SOURCE OF INFORMATION GR-2092

### DRILLER or DIGGER

### ADDITIONAL DATA:

Log Water Level Measurements Chemical Analysis Aquifer Test

### REMARKS: