

STATE ENGINEER  
Salem, Oregon

CLAC 00384

# Well Record


STATE WELL NO. 1/2-32  
COUNTY Clackamas  
APPLICATION NO. GR-2965

OWNER: Louis J. Merlo MAILING ADDRESS: 11811 S. E. Fuller Road

LOCATION OF WELL: Owner's No. CITY AND STATE: Milwaukie, Oregon

NW 1/4 SE 1/4 Sec. 32 T. 1 N. S. R. 2 W., W.M.

Bearing and distance from section or subdivision corner N. 47° 20' . 2445 feet

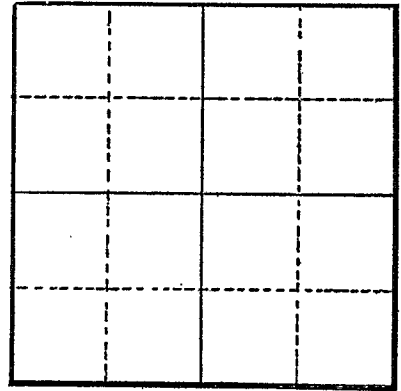

Section

Altitude at well

TYPE OF WELL: Drilled Date Constructed 1923

Depth drilled 80 feet Depth cased

### CASING RECORD:

### FINISH:

### AQUIFERS:

### WATER LEVEL:

PUMPING EQUIPMENT: Type General Electric, Type K. Code, J. Frame H.P. 3  
Capacity 30 G.P.M.

### WELL TESTS:

Drawdown ft. after hours G.P.M.  
Drawdown ft. after hours G.P.M.

USE OF WATER Irrigation Temp. °F. 19

SOURCE OF INFORMATION GR-2894

DRILLER or DIGGER

### ADDITIONAL DATA:

Log Water Level Measurements Chemical Analysis Aquifer Test

### REMARKS: