

STATE ENGINEER
Salem, Oregon

CLAC. 00382

Well Record

STATE WELL NO. 1/2-32L
COUNTY Clackamas
APPLICATION NO. CR-3648

OWNER: Nino Cartasegna & Sons
% Tino Cartasegna

MAILING ADDRESS: 6820 S.E. Maplehurst Road


LOCATION OF WELL: Owner's No.

CITY AND STATE: Milwaukie, Oregon

NE 1/4 SW 1/4 Sec. 32 T. 1 S., R. 2 W., W.M.

Bearing and distance from section or subdivision

corner S. 50°15' W. 4205 ft. from NE cor. Sec. 32

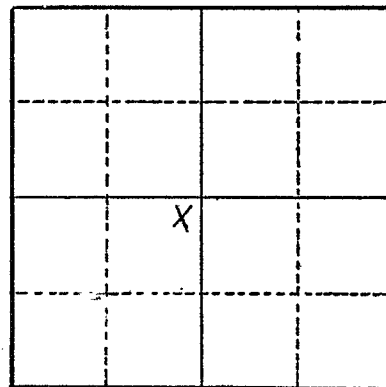

Section 32

Altitude at well

TYPE OF WELL: Drilled Date Constructed 1953

Depth drilled 270 ft. Depth cased 268.9 ft.

CASING RECORD:

8 inch standard plain and welded joints set from 0 to 268 or 269 feet

FINISH:

4 perforations per foot 3/16" x 1 1/2" from 90 to 157 feet
4 perforations per foot 3/16" x 1 1/2" from 200 to 265 feet

AQUIFERS:

WATER LEVEL:

65 feet below surface

PUMPING EQUIPMENT: Type Pomona turbine electric H.P. 15
Capacity 150 G.P.M.

WELL TESTS:

Drawdown 50 ft. after hours 150 G.P.M.

Drawdown ft. after hours G.P.M.

USE OF WATER Irrigation Temp. °F., 19

SOURCE OF INFORMATION Well Registration Statement

DRILLER or DIGGER

ADDITIONAL DATA:

Log X Water Level Measurements Chemical Analysis Aquifer Test

REMARKS:

