

STATE ENGINEER
Salem, Oregon

CLAC 00384


Well Record

STATE WELL NO. 1/2-32J
COUNTY Clackamas
APPLICATION NO. GR-4158

OWNER: John E. Strandberg
Strandberg's Floral and Garden
LOCATION OF WELL: Owner's No.

MAILING ADDRESS: 11711 SE 82nd
CITY AND STATE: Portland, Oregon

NE 1/4 SE 1/4 Sec. 32 T. 1 N. S., R. 2 E. W., W.M.
Bearing and distance from section or subdivision
corner about 900 feet South and 300 feet West
from E 1/4 Corner, Section 32.

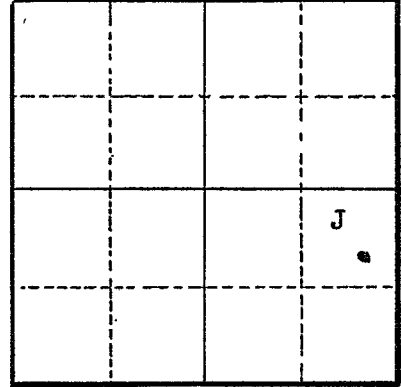

Section 32

Altitude at well

TYPE OF WELL: dug Date Constructed 1955

Depth drilled 18 feet Depth cased

CASING RECORD:

2 1/2-inch

FINISH:

AQUIFERS:

WATER LEVEL:

6 feet

PUMPING EQUIPMENT: Type Pacific JN 7A H.P.
Capacity 15 G.P.M.

WELL TESTS:

Drawdown 10 ft. after 15 hours G.P.M.
Drawdown ft. after hours G.P.M.

USE OF WATER Watering Greenhouse Temp. °F., 19

SOURCE OF INFORMATION GR-4043

DRILLER or DIGGER Otto Schultz

ADDITIONAL DATA:

Log (NA) Water Level Measurements Chemical Analysis Aquifer Test

REMARKS: