

STATE ENGINEER  
Salem, Oregon

CLAC 03862

Well Record

STATE WELL NO. 2/1-34M  
COUNTY Clackamas  
APPLICATION NO. GR-1659

OWNER: E. P. Pearson


MAILING ADDRESS: Rt. 1, Box 355

LOCATION OF WELL: Owner's No.

CITY AND STATE: West Linn, Oregon

NW 1/4 SW 1/4 Sec. 34 T. 2 S, R. 1 E, W.M.

Bearing and distance from section or subdivision corner 1900' N. & 400' E. from SW cor. Sec. 34.

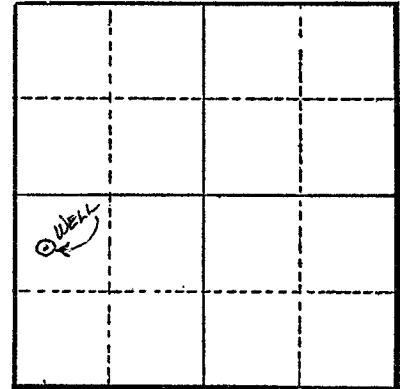

Section 34

Altitude at well Approx. 75'

TYPE OF WELL: Drilled Date Constructed 1951

Depth drilled 84' 1" Depth cased 84'

CASING RECORD:  
6"

FINISH:

AQUIFERS:

WATER LEVEL:

PUMPING EQUIPMENT: Type Homart jet H.P. 1  
Capacity 7 G.P.M.

WELL TESTS:

Drawdown ft. after hours G.P.M.  
Drawdown ft. after hours G.P.M.

USE OF WATER Irrigation & Domestic Temp. °F. 19

SOURCE OF INFORMATION GR Record

DRILLER or DIGGER Steinman Bros.

ADDITIONAL DATA:

Log N.A. Water Level Measurements Chemical Analysis Aquifer Test

REMARKS:

Irrigation of 1 acre.