

STATE ENGINEER
Salem, Oregon

CLnC 00390

Well Record

STATE WELL NO. 1/2-33J
COUNTY CLACKAMAS
APPLICATION NO. GR-2600

OWNER: Top O' Scott Golf Course


MAILING ADDRESS: 12000 S.E. Stevens Road

LOCATION OF WELL: Owner's No.

CITY AND STATE: Portland 66, Oregon

NE 1/4 SE 1/4 Sec. 33 T. 1 N S, R. 2 E W, W.M.

Bearing and distance from section or subdivision corner 1410' N. and 1050' W.

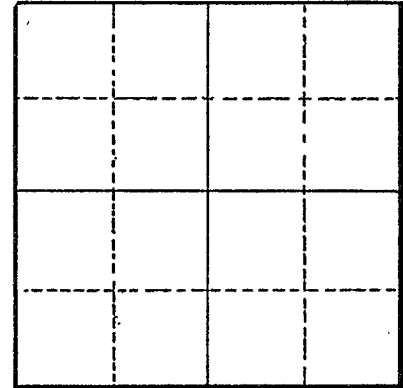

Section 353

Altitude at well

TYPE OF WELL: Drilled Date Constructed 1928

Depth drilled 353 Depth cased 353

CASING RECORD:

10-inch
8-inch

FINISH:

AQUIFERS: Clay, boulders, rock, sand and gravel

WATER LEVEL:

183-feet

PUMPING EQUIPMENT: Type Cook Turbine H.P. 100
Capacity 450 G.P.M.

WELL TESTS:

Drawdown ft. after hours G.P.M.
Drawdown ft. after hours G.P.M.

USE OF WATER Irrigation Temp. °F., 19

SOURCE OF INFORMATION GR-2467

DRILLER or DIGGER

ADDITIONAL DATA:

Log Water Level Measurements Chemical Analysis Aquifer Test

REMARKS:

| | | |
|-----------------|-----|-----|
| Clay | 6 | 6 |
| Boulders & clay | 21 | 27 |
| Solid rock | 152 | 179 |
| Clay | 30 | 209 |
| Cement gravel | 136 | 345 |
| Sand & Gravel | 8 | 353 |