

STATE ENGINEER
Salem, Oregon

CLAC 03968

Well Record

STATE WELL NO. 2/2-4A
COUNTY Clackamas
APPLICATION NO. GR-3101

OWNER: Gilbert C. Richardson


MAILING ADDRESS: 9700 S. E. Sunnyside Road

LOCATION OF WELL: Owner's No.

CITY AND STATE: Portland, Oregon

NE 1/4 NE 1/4 Sec. 4 T. 2 N. S. R. 2 W., W.M.

Bearing and distance from section or subdivision corner 1290 feet W. and 425 feet S.

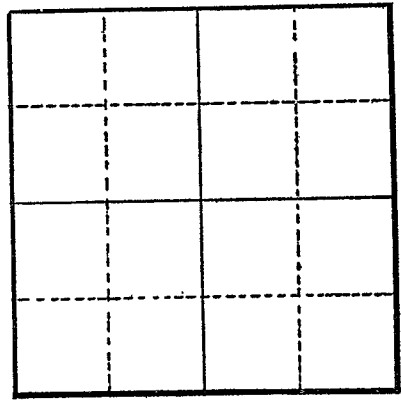

Section

Altitude at well

TYPE OF WELL: Drilled Date Constructed 1952

Depth drilled 225 feet Depth cased 225 feet

CASING RECORD:

- 10-inch
- 8-inch
- 8-inch

FINISH:

AQUIFERS:

Rock, water

WATER LEVEL:

85 feet

PUMPING EQUIPMENT: Type Berkey turbine H.P. 7 1/2
Capacity 120 G.P.M.

WELL TESTS:
Drawdown 20 ft. after hours Pumping 70 G.P.M.
Drawdown ft. after hours G.P.M.

USE OF WATER Irrigation and pasture Temp. °F., 19

SOURCE OF INFORMATION GR-2909
DRILLER or DIGGER Al Ziesing 9920 S. E. 82nd Avenue, Portland, Oregon

ADDITIONAL DATA:
Log Water Level Measurements Chemical Analysis Aquifer Test

REMARKS:

Hard rock at 39 feet
Some water at 42 feet 225 feet