



STATE ENGINEER  
Salem, Oregon

CLAG 03978 Well Record  
CLAC  
3979

STATE WELL NO. 2/2-5M1  
COUNTY MULTNOMAH  
APPLICATION NO.

OWNER: Union High School, Dist. 5  
MAILING ADDRESS:  
CITY AND STATE:


LOCATION OF WELL: Owner's No.  
N. E.  
1/4 1/4 Sec. T. S, R. W., W.M.

Bearing and distance from section or subdivision corner

Altitude at well 95

TYPE OF WELL: Drilled Date Constructed

Depth drilled 203 Depth cased 203

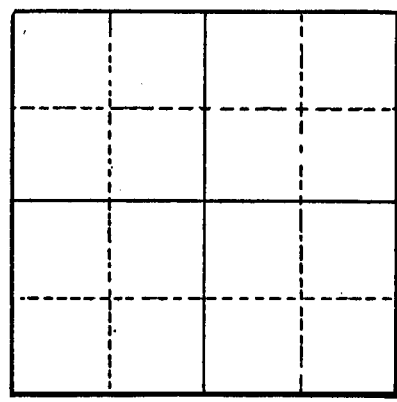

Section

CASING RECORD:

8-6 inch

FINISH:

AQUIFERS:

Cemented gravel, Troutdale Formation from 147 to 180  
Gravel, Sand " " " 187 to 188

WATER LEVEL:

8+ feet below land surface on November 2, 1957

PUMPING EQUIPMENT: Type Turbine H.P.  
Capacity G.P.M.

WELL TESTS:

Drawdown ft. after hours G.P.M.  
Drawdown ft. after hours G.P.M.

USE OF WATER Irrigation Temp. °F. 19

SOURCE OF INFORMATION USGS

DRILLER or DIGGER

ADDITIONAL DATA:

Log X Water Level Measurements Chemical Analysis Aquifer Test

REMARKS:

Pumped 135 gpm for 30 hours, drawdown 58 ft.  
Perforated 101-108, 124-131, 146-181, and 186-197 ft.  
Temperature 52° F.

