

STATE ENGINEER
Salem, Oregon

CLAC Well Record
03980

STATE WELL NO. 2/2-5K
COUNTY Clackamas
APPLICATION NO. GR-4006

OWNER: Eligio Valpreda


MAILING ADDRESS: 7525 SE Lake Rd.

LOCATION OF WELL: Owner's No.

CITY AND STATE: Milwaukie, Oregon

NW 1/4 SE 1/4 Sec. 5 T. 2 S., R. 2 E., W.M.

Bearing and distance from section or subdivision
corner 1630' W. & 2000' N. of SE Cor. Sec. 5

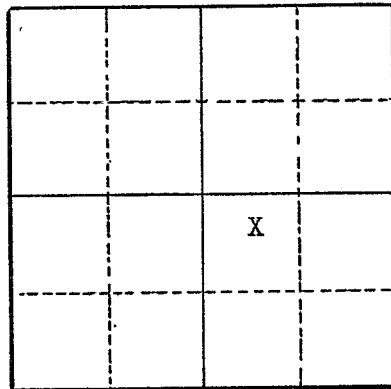

Section 5

Altitude at well

TYPE OF WELL: Drilled Date Constructed 1943

Depth drilled 112 ft. Depth cased

CASING RECORD:

FINISH:

AQUIFERS:

WATER LEVEL:

PUMPING EQUIPMENT: Type Pomona turbine 4" H.P. 5
Capacity 55 G.P.M.

WELL TESTS:
Drawdown ft. after hours G.P.M.
Drawdown ft. after hours G.P.M.

USE OF WATER Irrigation Temp. °F. 19
SOURCE OF INFORMATION Well Registration Statement Cert. # GR-3613
DRILLER or DIGGER Steinman Brothers Drilling Company

ADDITIONAL DATA:
Log Water Level Measurements Chemical Analysis Aquifer Test

REMARKS: