

STATE ENGINEER
Salem, Oregon

CLAC

03981

Well Record

STATE WELL NO. 2/2-5K
COUNTY CLACKAMAS
APPLICATION NO. GR-2971

OWNER: Greenever Nursery


MAILING ADDRESS: 125 E. Jersey

LOCATION OF WELL: Owner's No. _____

CITY AND STATE: Gladstone, Oregon

NW $\frac{1}{4}$ SE $\frac{1}{4}$ Sec. 5 T. 2 ^{N.} S., R. 2 ^{E.} W., W.M.

Bearing and distance from section or subdivision corner S. 30° W. 4175

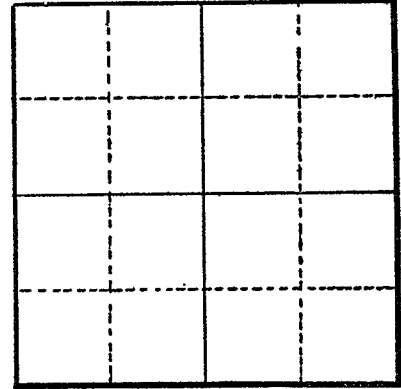

Section _____

Altitude at well _____

TYPE OF WELL: drilled Date Constructed 1954

Depth drilled 145 Depth cased 145

CASING RECORD:

6-inch

FINISH:

AQUIFERS:

WATER LEVEL:

80feet

PUMPING EQUIPMENT: Type Jacuzzi injector H.P. 5
Capacity 40 G.P.M.

WELL TESTS:

Drawdown _____ ft. after _____ hours _____ G.P.M.
Drawdown _____ ft. after _____ hours _____ G.P.M.

USE OF WATER irrigation Temp. _____ °F. _____, 19____

SOURCE OF INFORMATION GR-2785
DRILLER or DIGGER (Bill) Stennett, Wm. J., 361 Warner Milne Rd., Oregon City, Ore

ADDITIONAL DATA:

Log _____ Water Level Measurements _____ Chemical Analysis _____ Aquifer Test _____

REMARKS: