

STATE ENGINEER
Salem, Oregon

CLAC 03999 Well Record

STATE WELL NO. 2/2-7M
COUNTY Clackamas
APPLICATION NO. GR-3577

OWNER: A. O. Wright


MAILING ADDRESS: 16020 SE Harold Ave.

LOCATION OF WELL: Owner's No.

CITY AND STATE: Milwaukie, Oregon

NW 1/4 SW 1/4 Sec. 7 T. 2 S., R. 2 W., W.M.

Bearing and distance from section or subdivision
corner 1500' N. & 125' E. from SW Cor. Sec. 7

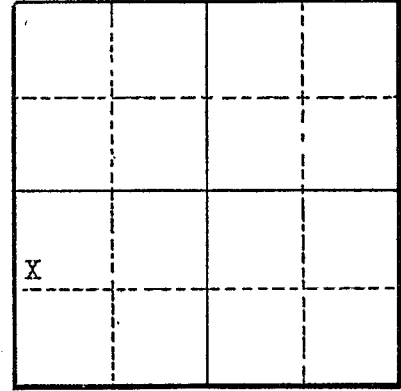

Altitude at well

TYPE OF WELL: Drilled Date Constructed 5/25/48

Depth drilled 203 ft. Depth cased 77 ft. 5 in.

Section 7

CASING RECORD:

6 inch standard threaded and coupled casing set to 77 ft. 5 in.

FINISH:

AQUIFERS:

WATER LEVEL:

48 feet below surface

PUMPING EQUIPMENT: Type Peerless H.P. 3
Capacity 50 G.P.M.

WELL TESTS:

Drawdown ft. after hours G.P.M.
Drawdown ft. after hours G.P.M.

USE OF WATER Irrigation Temp. °F. 19

SOURCE OF INFORMATION Well Registration Statement Cert. # GR-3577

DRILLER or DIGGER

ADDITIONAL DATA:

Log X Water Level Measurements Chemical Analysis Aquifer Test

REMARKS:

