

STATE ENGINEER
Salem, Oregon

CLAC
04011

Well Record

STATE WELL NO. 2/2-8B
COUNTY Clackamas
APPLICATION NO. GR-3631

OWNER: Rocco Cappelli


MAILING ADDRESS: 16809 1/2 Atfield Road.
SE.

LOCATION OF WELL: Owner's No. _____

CITY AND STATE: Milwaukie, Oregon

N. E.
NW 1/4 NE 1/4 Sec. 8 T. 2 S., R. 2 W., W.M.

Bearing and distance from section or subdivision
corner S. 46° 02' W. 183.4' & S. 42° 51' E. 267.6'
& S. 50° 36' E. 282.05' & S. 45° 53' W. 30' &
S. 39° 24' W. 5' from 1/4 cor. on the N. line
Sec. 8

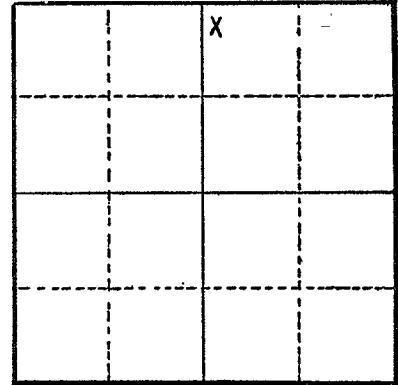

Section 8

Altitude at well _____

TYPE OF WELL: Drilled Date Constructed Dec., 1943

Depth drilled 301 feet Depth cased 70 feet

CASING RECORD:

6 inch iron casing set to 70 feet

FINISH:

AQUIFERS:

WATER LEVEL:

186 feet below surface

PUMPING EQUIPMENT: Type Reda Submersible H.P. 3
Capacity 24 G.P.M.

WELL TESTS:

Drawdown 0 ft. after _____ hours 24 G.P.M.
Drawdown _____ ft. after _____ hours _____ G.P.M.

USE OF WATER irrigation Temp. _____ °F., 19

SOURCE OF INFORMATION Well Registration Statement

DRILLER or DIGGER Steinman Bros.

ADDITIONAL DATA:

Log _____ Water Level Measurements _____ Chemical Analysis _____ Aquifer Test _____

REMARKS: