

STATE ENGINEER
Salem, Oregon

CLAC
04012

Well Record


STATE WELL NO. 2/2-8C(1)
COUNTY Clackamas
APPLICATION NO. GR-31

OWNER: Ernest B. Church
MAILING ADDRESS: 14920 S.E. Webster Rd.

LOCATION OF WELL: Owner's No. # 1
CITY AND STATE: Milwaukie, Oregon

NE 1/4 NW 1/4 Sec. 8 T. 2 N. S, R. 2 E. W., W.M.

Bearing and distance from section or subdivision corner

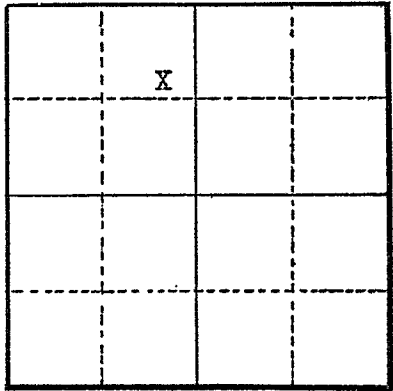

Section 8

Altitude at well 135 ft. Interpolated

TYPE OF WELL: drilled Date Constructed 4/51

Depth drilled 118 ft. Depth cased 115 ft.

CASING RECORD: 6 inch casing set from 0 to 115 ft.

FINISH: None

AQUIFERS: Sand, fine, from 53 to 57 ft. and sand and gravel from 110' to 118 ft.

WATER LEVEL: 57 ft. below land surface

PUMPING EQUIPMENT: Type "Cook" turbine 13 stage H.P. 5
Capacity 78 G.P.M.

WELL TESTS:
Drawdown 73 ft. after hours 78 G.P.M.
Drawdown 115 ft. after hours 140 G.P.M.

USE OF WATER Irrigation 12.4 acres Temp. °F., 19

SOURCE OF INFORMATION Registration Statement GR-31

DRILLER or DIGGER

ADDITIONAL DATA:
Log X Water Level Measurements Chemical Analysis Aquifer Test

REMARKS: Log:

Top soil 0 - 53 ft. 53 ft. thick
Sand, fine 53 - 110 ft. 57 ft. thick
Sand, coarse 110-118 ft. 8 ft. thick