

STATE ENGINEER
Salem, Oregon

CLAC
04024

Well Record

STATE WELL NO. 2/2-9K
COUNTY Clackamas
APPLICATION NO: GR-2355

OWNER: Franz O. Kruschke


MAILING ADDRESS: _____

LOCATION OF WELL: Owner's No. _____

CITY AND STATE: Clackamas, Oregon

NW $\frac{1}{4}$ SE $\frac{1}{4}$ Sec. 9 T. 2 S., R. 2 W, W.M.

Bearing and distance from section or subdivision corner _____

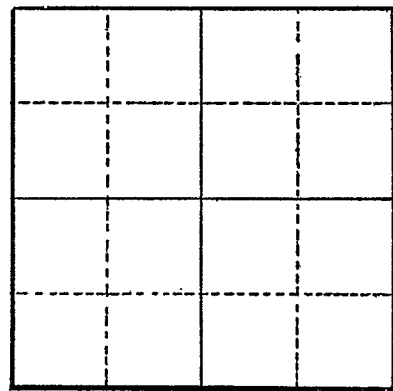

Altitude at well _____

TYPE OF WELL: drilled Date Constructed 1949

Depth drilled 84 ft. Depth cased 84 ft.

Section _____

CASING RECORD: 8 inch

FINISH: _____

AQUIFERS: _____

WATER LEVEL: 20 ft.

PUMPING EQUIPMENT: Type Jacuzzi submersible H.P. 5
Capacity 80 G.P.M.

WELL TESTS:
Drawdown 60 ft. after _____ hours pump on 80 G.P.M.
Drawdown _____ ft. after _____ hours _____ G.P.M.

USE OF WATER Irrigation Temp. _____ °F., 19 _____

SOURCE OF INFORMATION GR-2237

DRILLER or DIGGER _____

ADDITIONAL DATA:

Log _____ Water Level Measurements _____ Chemical Analysis _____ Aquifer Test _____

REMARKS: _____