

STATE ENGINEER
Salem, Oregon

CLAC
04026

Well Record

STATE WELL NO. 2/2-9N
COUNTY Clackamas
APPLICATION NO. GR-4261

OWNER: H. Niklas, President of Clackamas Greenhouses, Inc.

MAILING ADDRESS: _____


LOCATION OF WELL: Owner's No. _____

CITY AND STATE: _____

Clackamas, Oregon

SW $\frac{1}{4}$ SW $\frac{1}{4}$ Sec. 9 T. 2 S., R. 2 ^{N.} ~~W.~~, W.M.

Bearing and distance from section or subdivision corner 200 feet North and 300 feet East of the SW Corner, of Section 9

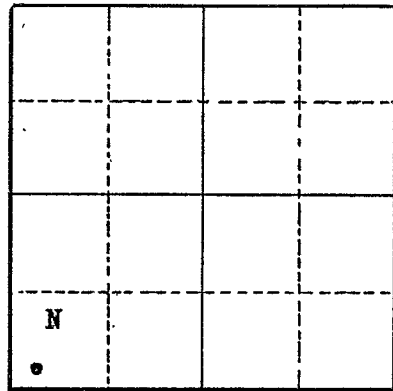

Section 9

Altitude at well 150 feet

TYPE OF WELL: Drilled Date Constructed May, 1920

Depth drilled 29 feet Depth cased 29 feet

CASING RECORD:

6-inch casing set from 0 to 29 feet

FINISH:

AQUIFERS:

WATER LEVEL:

20 feet

PUMPING EQUIPMENT: Type Turbine

H.P. _____

Capacity _____ G.P.M.

WELL TESTS:

Drawdown _____ ft. after _____ hours _____ G.P.M.

Drawdown _____ ft. after _____ hours _____ G.P.M.

USE OF WATER Greenhouse

Temp. _____ °F., 19 _____

SOURCE OF INFORMATION GR-4112

DRILLER or DIGGER _____

ADDITIONAL DATA:

Log (NA) Water Level Measurements _____ Chemical Analysis _____ Aquifer Test _____

REMARKS: