

STATE ENGINEER  
Salem, Oregon

CLAC  
04200

# Well Record

STATE WELL NO. 2/2-18Q  
COUNTY CLACKAMAS  
APPLICATION NO. GR-2516

OWNER: Carl Starker


MAILING ADDRESS: Jemmings Lodge

LOCATION OF WELL: Owner's No.

CITY AND STATE: Gladstone, Oregon

SW 1/4 SE 1/4 Sec. 18 T. 2 N. S., R. 2 W., W.M.

Bearing and distance from section or subdivision corner about 2510' W & 200' N from SE corner Section 18

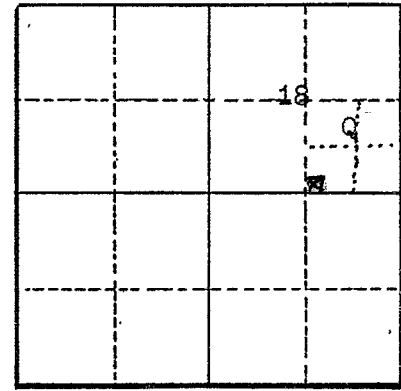

Section 18

Altitude at well

TYPE OF WELL: drilled Date Constructed 1932

Depth drilled 214' Depth cased

### CASING RECORD:

Not Available

### FINISH:

Not Available

### AQUIFERS:

### WATER LEVEL:

60'

PUMPING EQUIPMENT: Type Jacuzzi Jet Pump H.P. 3  
Capacity 25 G.P.M.

### WELL TESTS:

Drawdown ft. after hours G.P.M.  
Drawdown ft. after hours G.P.M.

USE OF WATER Irrigation Temp. °F. 19

SOURCE OF INFORMATION GR-3826  
DRILLER or DIGGER Zeizing (Deceased)

### ADDITIONAL DATA:

Log NA Water Level Measurements Chemical Analysis Aquifer Test

### REMARKS: