

STATE ENGINEER
Salem, Oregon

CLAC
04247

Well Record

STATE WELL NO. 2/2-21J
COUNTY CLACKAMAS
APPLICATION NO. GR-2414

OWNER: Albert M. Herbst


MAILING ADDRESS: Rt. 5, Box 751,

LOCATION OF WELL: Owner's No.

CITY AND STATE: Oregon City, Oregon

NE 1/4 SE 1/4 Sec. 21 T. 2 N. S. R. 2 E. W.M.

Bearing and distance from section or subdivision corner 1000' S. and 900' W.

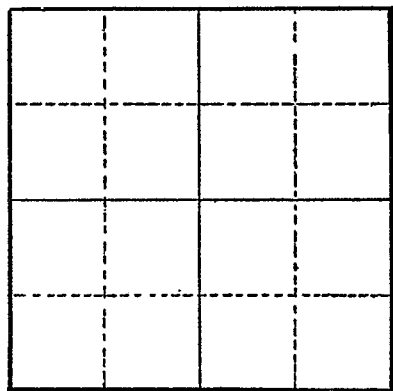

Section

Altitude at well

TYPE OF WELL: Drilled Date Constructed 1955

Depth drilled 272 Depth cased 266

CASING RECORD:

6-inch

FINISH:

AQUIFERS:

Topsoil, clay, sand and gravel

WATER LEVEL:

227-feet

PUMPING EQUIPMENT: Type Berkeley Turbine H.P. 15

Capacity 100 G.P.M.

WELL TESTS:

Drawdown 5 ft. after hours Pumping 100 G.P.M.

Drawdown ft. after hours G.P.M.

USE OF WATER Irrigation Temp. °F., 19

SOURCE OF INFORMATION GR-2294

DRILLER or DIGGER Drilled well ourselves

ADDITIONAL DATA:

Log Water Level Measurements Chemical Analysis Aquifer Test

REMARKS:

