

STATE ENGINEER
Salem, Oregon

Well Record

STATE WELL NO. 2/2-21K
COUNTY CLATSOP
APPLICATION NO. GR-4014

CLAC

04249

OWNER: GUS PIETZ


MAILING ADDRESS: Rt 5, Box 774

LOCATION OF WELL: Owner's No.

CITY AND STATE: Oregon City, Oregon

NW 1/4 SE 1/4 Sec. 21 T. 2 S., R. 2 E., W.M.

Bearing and distance from section or subdivision corner N 61°W, 2950' from SE cor Sec 21

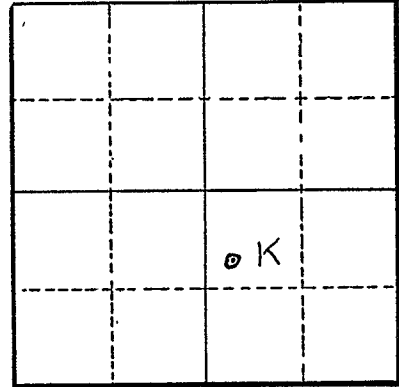

Section 21

Altitude at well

TYPE OF WELL: Drilled Date Constructed 1922

Depth drilled 365' Depth cased

CASING RECORD:

FINISH:

AQUIFERS:

WATER LEVEL:

100'

PUMPING EQUIPMENT: Type Fairbanks Morris H.P. 5
Capacity 100 G.P.M.

WELL TESTS:

Drawdown ft. after hours G.P.M.
Drawdown ft. after hours G.P.M.

USE OF WATER Irrigation Temp. °F., 19

SOURCE OF INFORMATION GR-3961

DRILLER or DIGGER A. R. Sanetel & Son

ADDITIONAL DATA:

Log NA Water Level Measurements Chemical Analysis Aquifer Test

REMARKS: