

STATE ENGINEER
Salem, Oregon

CLAC 04278 Well Record
GR-1779

STATE WELL NO. 2/2-22J
COUNTY Clackamas
APPLICATION NO. GR-1834

OWNER: Rufus W. & Keith K. Baker

MAILING ADDRESS: Rt. 5, Box 709


LOCATION OF WELL: Owner's No.

CITY AND STATE: Oregon City, Oregon

NE 1/4 SE 1/4 Sec. 22 T. 2 N. S., R. 2 E. W.M.

Bearing and distance from section or subdivision

corner 351' S. & 42' E. from NW cor. of NE 1/4 SE 1/4 of Sec. 22.

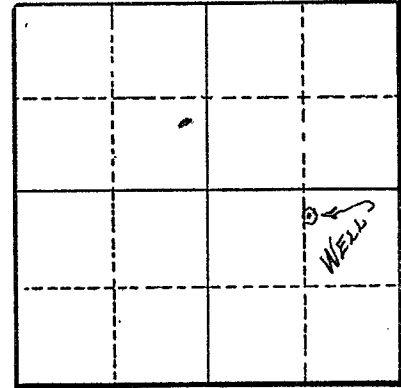

Section 22

Altitude at well

TYPE OF WELL: Drilled Date Constructed 1955

Depth drilled 198' Depth cased 25'

CASING RECORD:

8"

FINISH:

AQUIFERS:

WATER LEVEL:

160'

PUMPING EQUIPMENT: Type Jacuzzi jet H.P. 3
Capacity 10 G.P.M.

WELL TESTS:

Drawdown ft. after hours G.P.M.
Drawdown ft. after hours G.P.M.

USE OF WATER Irrigation Temp. °F., 19

SOURCE OF INFORMATION GR Record

DRILLER or DIGGER Bill Stinett

ADDITIONAL DATA:

Log Water Level Measurements Chemical Analysis Aquifer Test

REMARKS:

Log: Dirt 0 to 25 ft.
Rock, hard 25 to 198 ft.

Irrigation of 3 1/2 acres.