

STATE ENGINEER
Salem, Oregon

Well Record

STATE WELL NO. 2/24-24L
COUNTY Clackamas
APPLICATION NO. GR-2831

OWNER: Charles James McGloin

MAILING ADDRESS: Route 5, Box 684


LOCATION OF WELL: Owner's No.

CITY AND STATE: Oregon City, Oregon

NE 1/4 SW 1/4 Sec. 24 T. 2 N. S., R. 2 E. W., W.M.

Bearing and distance from section or subdivision

corner 1870 feet East and 80 feet South from the
W 1/4 Corner, Section 24.

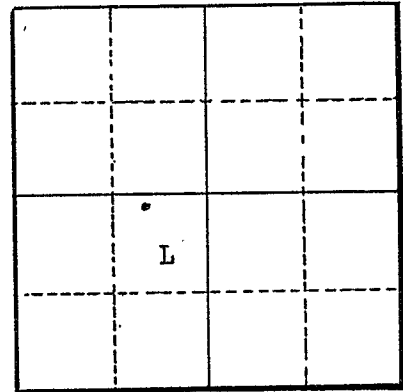

Altitude at well

TYPE OF WELL: Drilled Date Constructed 8-9-44

Depth drilled 352 feet Depth cased 352 feet

Section 24

CASING RECORD:

6" casing set from 0 to 47 feet
4" casing set from 289 to 352 feet

FINISH:

Perforated line 33 - 1/4 X 6 perforations

AQUIFERS:

WATER LEVEL:

319 feet

PUMPING EQUIPMENT: Type V2958 Myers Rod pump H.P.
Capacity 8 G.P.M.

WELL TESTS:

Drawdown No ft. after 8 hours G.P.M.
Drawdown ft. after hours G.P.M.

USE OF WATER Irrigation Temp. °F. 19

SOURCE OF INFORMATION GR-4028

DRILLER or DIGGER Zeizing drilled

ADDITIONAL DATA:

Log (NA) Water Level Measurements Chemical Analysis Aquifer Test

REMARKS: