

STATE ENGINEER
Salem, Oregon

CLAG Well Record
04403

STATE WELL NO. 2/2-29A
COUNTY CLACKAMAS
APPLICATION NO. GR-2063

OWNER: Claud & Sarie M. Salisbury


MAILING ADDRESS: RT. 5 Box 29

LOCATION OF WELL: Owner's No.

CITY AND STATE: Oregon City, Oregon

NE 1/4 NE 1/4 Sec. 29 T. 2 S., R. 2 E., W.M.

Bearing and distance from section or subdivision corner 1250' W & 260' S for NE corner of Sec 29

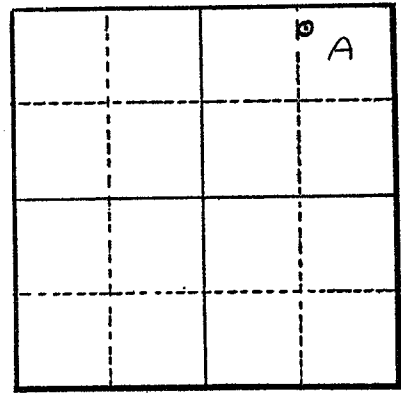

Altitude at well

TYPE OF WELL: Drilled Date Constructed 1946

Depth drilled 90' Depth cased 90'

Section 29

CASING RECORD:
6-inch

FINISH:

AQUIFERS:
soil, hard rock, sandstone

WATER LEVEL:
15'

PUMPING EQUIPMENT: Type Pacific Pump H.P. 1 1/2
Capacity 2400 G.P.M.

WELL TESTS:
Drawdown 15 ft. after _____ hours 40 G.P.M.
Drawdown _____ ft. after _____ hours _____ G.P.M.

USE OF WATER Irrigation Temp. °F. 19

SOURCE OF INFORMATION GR-3870

DRILLER or DIGGER

ADDITIONAL DATA:
Log Water Level Measurements _____ Chemical Analysis _____ Aquifer Test _____

REMARKS:
20' soil 20'
Hard rock 40'
Sandstone & weathered 30'
buralt