

STATE ENGINEER  
Salem, Oregon

CLAC

# Well Record

04419

STATE WELL NO. 2/2-31F(1)  
COUNTY Clackamas  
APPLICATION NO. GR-707

OWNER: Publisher's Paper Co.


MAILING ADDRESS: \_\_\_\_\_

LOCATION OF WELL: Owner's No. 1

CITY AND STATE: Oregon City, Oregon

SE 1/4 NW 1/4 Sec. 31 T. 2 N. S. R. 2 E. W., W.M.

Bearing and distance from section or subdivision corner Approx. 3370 feet West & 2380 feet South from NE corner of Section 31, T.2 S. R. 2 E.

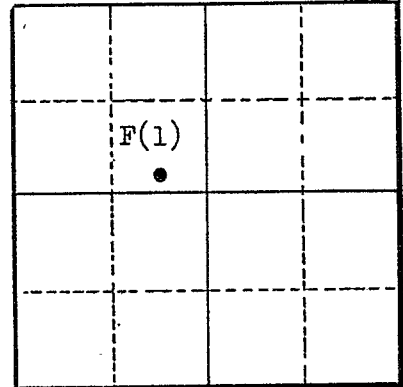

Section 31

Altitude at well 120' Interpolated

TYPE OF WELL: Drilled Date Constructed 1940

Depth drilled 250' Depth cased 17'

### CASING RECORD:

12-inch

### FINISH:

### AQUIFERS:

### WATER LEVEL:

49 feet

PUMPING EQUIPMENT: Type Deming turgine H.P. 20  
Capacity 220 G.P.M.

WELL TESTS:  
Drawdown 41 ft. after \_\_\_\_\_ hours 230 G.P.M.  
Drawdown \_\_\_\_\_ ft. after \_\_\_\_\_ hours \_\_\_\_\_ G.P.M.

USE OF WATER Manufacturing Temp. \_\_\_\_\_ °F. \_\_\_\_\_, 19\_\_\_\_

SOURCE OF INFORMATION GR-707

DRILLER or DIGGER R.J. Strasser Drilling Co., Portland, Oregon

### ADDITIONAL DATA:

Log  Water Level Measurements \_\_\_\_\_ Chemical Analysis \_\_\_\_\_ Aquifer Test \_\_\_\_\_

### REMARKS:

