

STATE ENGINEER
Salem, Oregon

CLACKAMAS Well Record

00450

GR- 1192

STATE WELL NO. 1/3-25J(1).
COUNTY Clackamas
APPLICATION NO. GR- 1233

OWNER: Michio Sakawye

MAILING
ADDRESS:

LOCATION OF WELL: Owner's No.

CITY AND
STATE:

Boring, Oregon

NE 1/4 SE 1/4 Sec. 25 T. 1 S. R. 3 E. W.M.


Bearing and distance from section or subdivision

corner S5°W. 3438' from NE cor. Sec. 25.

Altitude at well 500 ft.

TYPE OF WELL: Drilled Date Constructed 1955

Depth drilled 250 ft. Depth cased 250 ft.

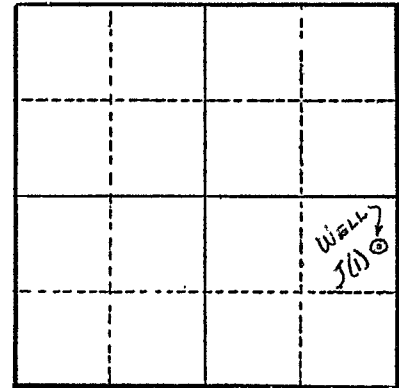

Section 25

CASING RECORD:

6 in. from 0 to 167 ft.

5 in. from 167 to 250 ft.

FINISH:

90' - 5 in. pipe perforated from 167 to 250 ft. (Torch cut 3 cuts per ft.)

AQUIFERS:

Water in cement gravel at 165 to 167 ft.

" " " " 200 to 250 ft.

WATER LEVEL:

140 ft.

PUMPING EQUIPMENT: Type Myers submersible

H.P. 2

Capacity 25 G.P.M.

WELL TESTS:

Drawdown 50 ft. after 25 hours G.P.M.

Drawdown ft. after hours G.P.M.

USE OF WATER Irrigation Temp. °F. 19

SOURCE OF INFORMATION G. R. Record

DRILLER or DIGGER

ADDITIONAL DATA:

Log X Water Level Measurements Chemical Analysis Aquifer Test

REMARKS:

Irrigation of 20 acres.

STATE ENGINEER
Salem, Oregon

State Well No. 1/3-25J(1)
County Clackamas
Application No. GR- 1233

Well Log

Owner: Michio Sakawye Owner's No. _____

Driller: _____ Date Drilled 1955

[illegible]