

STATE ENGINEER
Salem, Oregon

CLAC
4514

Well Record


STATE WELL NO. 2/3-1H
COUNTY Clackamas
APPLICATION NO. GR-3909

OWNER: George A. Gottman MAILING ADDRESS: Route 3, Box 248

LOCATION OF WELL: Owner's No. _____ CITY AND STATE: Boring, Oregon

SE 1/4 NE 1/4 Sec. 1 T. 2 S., R. 3 E., W.M.

Bearing and distance from section or subdivision corner S. 16°15' W. NE Cor. Sec. 1

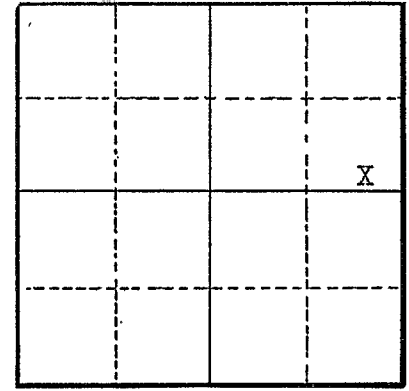

Section 1

Altitude at well _____

TYPE OF WELL: Drilled Date Constructed Mar., 1952

Depth drilled 200 ft. Depth cased 20 ft.

CASING RECORD:

8 inch casing set to 200 ft.

FINISH:

perforations from 82 to 85 ft., 104 to 108 ft., 134 to 195 ft.

AQUIFERS:

WATER LEVEL:

28 ft. below surface

PUMPING EQUIPMENT: Type Jacuzzi turbine H.P. 10
Capacity 250 G.P.M.

WELL TESTS:

Drawdown	<u>82</u>	ft. after	_____	hours	<u>150</u>	_____	G.P.M.
Drawdown	<u>100</u>	ft. after	_____	hours	<u>210</u>	_____	G.P.M.

USE OF WATER Irrigation Temp. _____ °F., 19 _____

SOURCE OF INFORMATION Well Registration Statement Cert. # GR-3549

DRILLER or DIGGER A. O. Olson

ADDITIONAL DATA:

Log X Water Level Measurements _____ Chemical Analysis _____ Aquifer Test _____

REMARKS:

Log		Thickness	Depth to Bottom
Clay		<u>1</u>	<u>7</u>
Cemented gravel		<u>193</u>	<u>200</u>