

STATE ENGINEER
Salem, Oregon

CLAC
04516

Well Record

STATE WELL NO. 2/3-1R(1)
COUNTY Clackamas
APPLICATION NO. GR-1044

GR- 1006

OWNER: K. Nishikawa


MAILING ADDRESS: Rt. 3, Box 236

LOCATION OF WELL: Owner's No.

CITY AND STATE: Boring, Oregon

SE 1/4 SE 1/4 Sec. 1 T. 2 S., R. 3 E., W.M.

Bearing and distance from section or subdivision corner N86°W. 1305' from SE cor. of Sec. 1.

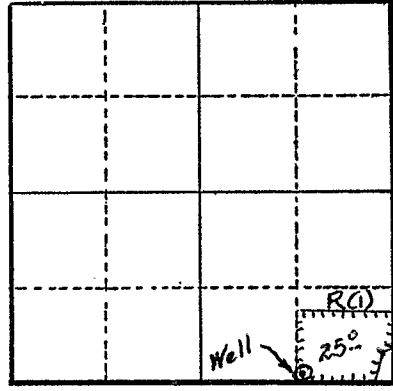

Section 1

Altitude at well 600 ft.

TYPE OF WELL: Drilled Date Constructed 1953

Depth drilled 210 ft. Depth cased 210 ft.

CASING RECORD:

- 6 inch from 0 to 200 ft.
- 5 inch from 200 to 210 ft.

FINISH:

Perforated 5" liner from 200 to 210 ft.

AQUIFERS:

WATER LEVEL:

190 ft.

PUMPING EQUIPMENT: Type Myers submersible H.P. 2
Capacity 30 G.P.M.

WELL TESTS:

Drawdown 5 ft. after 30 hours G.P.M.

Drawdown ft. after hours G.P.M.

USE OF WATER Irrigation Temp. °F., 19.

SOURCE OF INFORMATION G.R. Record

DRILLER or DIGGER A. B. Olson

ADDITIONAL DATA:

Log N.A. Water Level Measurements Chemical Analysis Aquifer Test

REMARKS:

Irrigation of 25 acres.