


STATE ENGINEER
Salem, Oregon

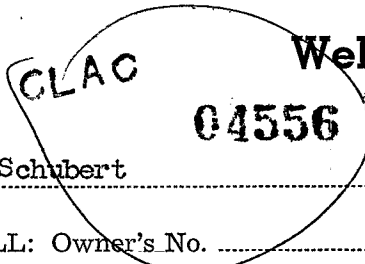

Well Record

STATE WELL NO. 2/3-3J
COUNTY Clackamas
APPLICATION NO. GR-1684

GR- 1634

OWNER: Walter Schubert


MAILING ADDRESS: Rt. 2, Box 377

LOCATION OF WELL: Owner's No.

CITY AND STATE: Boring, Oregon

NE 1/4 SE 1/4 Sec. 3 T. 2 S., R. 3 E. W.M.

Bearing and distance from section or subdivision corner 2235' N.3°W. from SE cor. Sec. 3

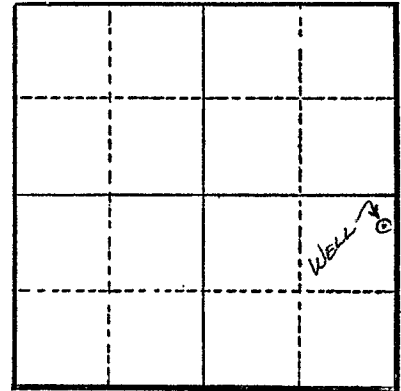

Altitude at well 567'

Section 3

TYPE OF WELL: Drilled Date Constructed 1951

Depth drilled 210' Depth cased 210'

CASING RECORD:
6"

FINISH:

AQUIFERS:

WATER LEVEL:
190'

PUMPING EQUIPMENT: Type F. M. 4" turbine H.P. 3
Capacity 100 G.P.M.

WELL TESTS:
Drawdown ft. after hours G.P.M.
Drawdown ft. after hours G.P.M.

USE OF WATER Irrigation Temp. °F., 19

SOURCE OF INFORMATION GR Record

DRILLER or DIGGER Olsen Drilling Co.

ADDITIONAL DATA:
Log N.A. Water Level Measurements Chemical Analysis Aquifer Test

REMARKS:

Irrigation of 38 acres.