


STATE ENGINEER
Salem, Oregon

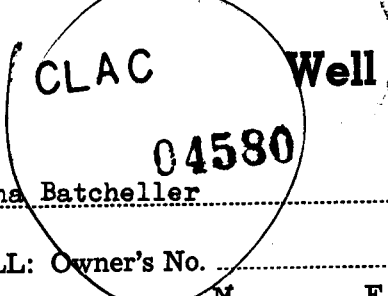

Well Record

STATE WELL NO. 2/3-5K
COUNTY Clackamas
APPLICATION NO. GR-448

OWNER: Erna Batcheller


MAILING ADDRESS: Route 2, Box 412

LOCATION OF WELL: Owner's No.

CITY AND STATE: Boring, Oregon

NW 1/4 SE 1/4 Sec. 5 T. 2 N. S., R. 3 E., W.M.

Bearing and distance from section or subdivision corner N. 36° W 2477' from SE corner Section 5

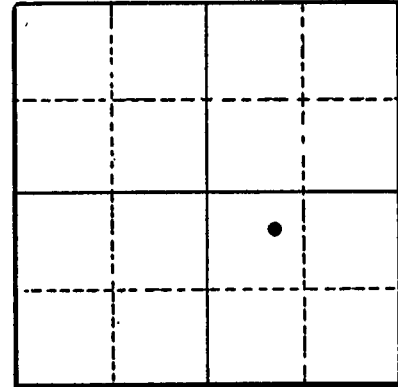

Section 5

Altitude at well 580

TYPE OF WELL: Drilled Date Constructed Oct. 1949

Depth drilled 240 Depth cased 0-240'

CASING RECORD:

0' - 240' 8" casing

FINISH:

Perforated-16 per foot

AQUIFERS:

195 - 240 loose water and filled gravel

WATER LEVEL:

162

PUMPING EQUIPMENT: Type Cook turbine H.P. 15
Capacity 190 G.P.M.

WELL TESTS:

Drawdown 40 ft. after 190 hours G.P.M.
Drawdown 30 ft. after 115 hours G.P.M.

USE OF WATER Irrigation Temp. °F., 19

SOURCE OF INFORMATION Erna Batcheller

DRILLER or DIGGER

ADDITIONAL DATA:
Log x Water Level Measurements 162 static Chemical Analysis Aquifer Test

REMARKS:

