

STATE ENGINEER  
Salem, Oregon

CLAC  
04584

# Well Record

STATE WELL NO. 2/3-59  
COUNTY Clackamas  
APPLICATION NO. GR-4002

OWNER: Elmer M. Schweitzer


MAILING ADDRESS: 621 N. Sumner

LOCATION OF WELL: Owner's No. \_\_\_\_\_

CITY AND STATE: Portland, Oregon

SW 1/4 SE 1/4 Sec. 5 T. 2 S., R. 3 W., W.M.

Bearing and distance from section or subdivision corner 2350' WNW of SE Cor. Sec. 5

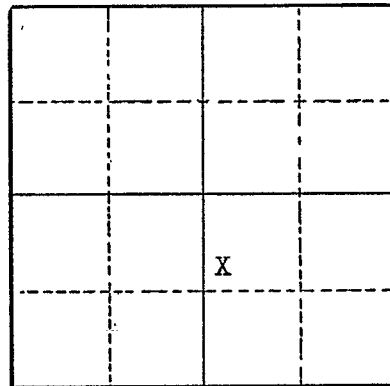

Section 5

Altitude at well \_\_\_\_\_

TYPE OF WELL: Drilled Date Constructed 6/46

Depth drilled 105 ft. Depth cased 38 ft.

### CASING RECORD:

8 inch casing set to 38 feet

### FINISH:

### AQUIFERS:

### WATER LEVEL:

50 feet below surface

PUMPING EQUIPMENT: Type Deming centrifugal pump H.P. 3  
Capacity 30 G.P.M.

### WELL TESTS:

Drawdown 70 ft. after \_\_\_\_\_ hours 50 G.P.M.

Drawdown \_\_\_\_\_ ft. after \_\_\_\_\_ hours \_\_\_\_\_ G.P.M.

USE OF WATER Irrigation Temp. \_\_\_\_\_ °F., 19 \_\_\_\_\_

SOURCE OF INFORMATION Well Registration Statement Cert. # GR-3609

DRILLER or DIGGER A. O. Olsen

### ADDITIONAL DATA:

Log \_\_\_\_\_ Water Level Measurements \_\_\_\_\_ Chemical Analysis \_\_\_\_\_ Aquifer Test \_\_\_\_\_

### REMARKS: