

STATE ENGINEER
Salem, Oregon

CLAC

04590

Well Record

STATE WELL NO. 2/3-5R
COUNTY CLACKAMAS
APPLICATION NO. GR-2314

OWNER: Mabel I Wescott


MAILING ADDRESS: Route 2, Box 550

LOCATION OF WELL: Owner's No.

CITY AND STATE: Boring, Oregon

SE 1/4 SE 1/4 Sec. 5 T. 2 N. S., R. 3 E. W.M.

Bearing and distance from section or subdivision corner 1140' N 87°0' W (SE corner Section 5)

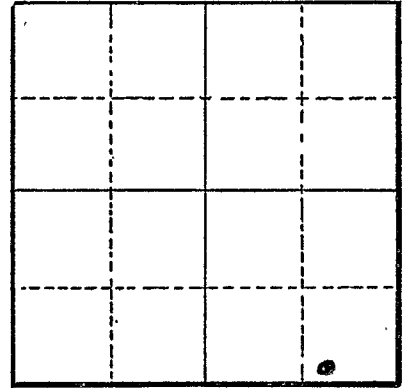

Section 5

Altitude at well

TYPE OF WELL: Drilled Date Constructed 1938

Depth drilled 74' Depth cased 18'

CASING RECORD:

6-inch

FINISH:

AQUIFERS:

Top Soil and Clay, Rock

WATER LEVEL: 42'

PUMPING EQUIPMENT: Type Myers Ejects H.P. 1/2
Capacity 5 G.P.M.

WELL TESTS:

Drawdown	8	ft. after	hours	180	G.P.M.
Drawdown	2	ft. after	hours	120	G.P.M.

USE OF WATER Irrigation Temp. °F. 19

SOURCE OF INFORMATION GR-3830

DRILLER or DIGGER NA

ADDITIONAL DATA:

Log Water Level Measurements Chemical Analysis Aquifer Test

REMARKS:

Clay, Top Soil 16' to 58'
Rock 58' to -