

STATE ENGINEER
Salem, Oregon

OBSERVATION WELL

CLAC 04614

Well Record


STATE WELL NO. 2/3-6F(1)
COUNTY Clackamas
APPLICATION NO. GR-104

OWNER: Lewis Isaacs MAILING ADDRESS: Route 1, Box 279

LOCATION OF WELL: Owner's No. 1 CITY AND STATE: Clackamas, Oregon

SE 1/4 NW 1/4 Sec. 6 T. 2 N. S. R. 3 W., W.M.

Bearing and distance from section or subdivision corner S. 50° 10' E. 2660' from the NW corner Section 6

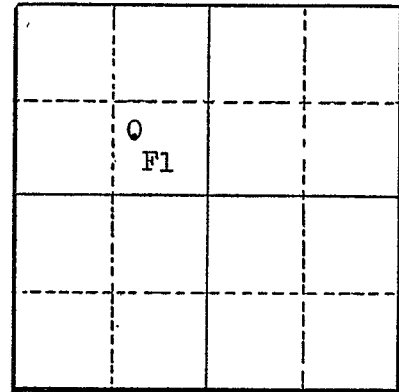

Altitude at well 340' Interpolated

TYPE OF WELL: Drilled Date Constructed March 1952

Depth drilled 227 Depth cased 227

Section 6

CASING RECORD:

8-inch casing set from 0 to 227 feet

FINISH:

no record

AQUIFERS:

gravel from 130' to 227'

WATER LEVEL:

75 feet below land surface April 1952

PUMPING EQUIPMENT: Type 4" Jacuzzi turbine GE 3 phase H.P. 10
Capacity 120 G.P.M.

WELL TESTS:

Drawdown 116 ft. after hours 105 G.P.M.
Drawdown ft. after hours G.P.M.

USE OF WATER Irrigation 12.9 acres Temp. °F. 19

SOURCE OF INFORMATION Registration Statement GR-104

DRILLER or DIGGER

ADDITIONAL DATA:

Log Water Level Measurements Chemical Analysis Aquifer Test

REMARKS:

