

STATE ENGINEER
Salem, Oregon

CLAC
04616

Well Record

STATE WELL NO. 2/3-691
COUNTY MULTNOMAH
APPLICATION NO.

OWNER: J. W. Aylett


MAILING ADDRESS:

LOCATION OF WELL: Owner's No.

CITY AND STATE:

..... 1/4 1/4 Sec. T. N. S., R. E. W., W.M.

Bearing and distance from section or subdivision corner

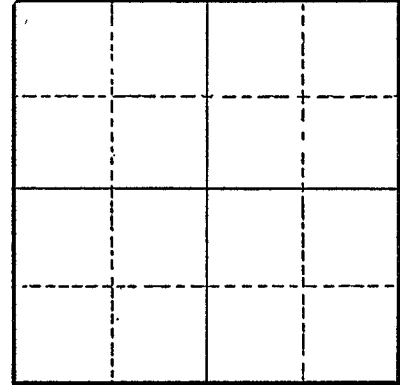

Section

Altitude at well 430

TYPE OF WELL: Drilled Date Constructed

Depth drilled 105 Depth cased 105

CASING RECORD:

6 inch

FINISH:

AQUIFERS:

Basalt, Boring lava from 90 to 105

WATER LEVEL:

88 feet below land surface, July, 1956

PUMPING EQUIPMENT: Type Submersible H.P.
Capacity 35 G.P.M.

WELL TESTS:

Drawdown ft. after hours G.P.M.

Drawdown ft. after hours G.P.M.

USE OF WATER Domestic, Irrigation Temp. °F., 19

SOURCE OF INFORMATION USGS

DRILLER or DIGGER

ADDITIONAL DATA:

Log Water Level Measurements Chemical Analysis Aquifer Test

REMARKS:

Bailed 20 gpm, drawdown 5 ft. after 1 hour.
Perforated 95-105 ft.
Temperature 52° F.

