

STATE ENGINEER  
Salem, Oregon

CLAC

04736

# Well Record

STATE WELL NO. 2/3-11M(1)  
COUNTY Clackamas  
APPLICATION NO. GR-443

OWNER: Carl Garnee

MAILING

ADDRESS: Rt. 3, Box 271

LOCATION OF WELL: Owner's No. \_\_\_\_\_


CITY AND

STATE: Boring, Oregon

.....NW ¼ SW ¼ Sec. 11 T. 2 N. S., R. 3 E. W.M.

Bearing and distance from section or subdivision

corner S. 2° E. 2662 ft. from the NW Cor. Sec. 11

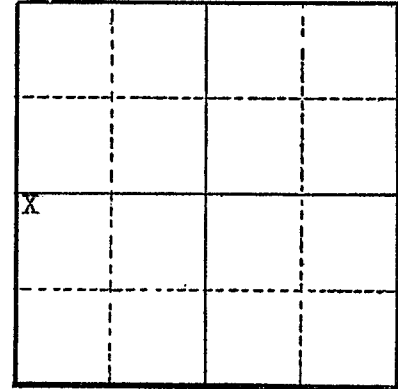

Section 11

Altitude at well \_\_\_\_\_

TYPE OF WELL: drilled Date Constructed 7/5/40

Depth drilled 179 ft. Depth cased 179 ft.

CASING RECORD: 8 inch

FINISH: \_\_\_\_\_

AQUIFERS: \_\_\_\_\_

WATER LEVEL: 152 ft.

PUMPING EQUIPMENT: Type Pamona turbine H.P. 10  
Capacity 60 G.P.M.

WELL TESTS:

Drawdown \_\_\_\_\_ ft. after \_\_\_\_\_ hours \_\_\_\_\_ G.P.M.

Drawdown \_\_\_\_\_ ft. after \_\_\_\_\_ hours \_\_\_\_\_ G.P.M.

USE OF WATER Irrigation Temp. \_\_\_\_\_ °F., 19

SOURCE OF INFORMATION GR-443

DRILLER or DIGGER \_\_\_\_\_

ADDITIONAL DATA:

Log  Water Level Measurements \_\_\_\_\_ Chemical Analysis \_\_\_\_\_ Aquifer Test \_\_\_\_\_

REMARKS: \_\_\_\_\_

