

STATE ENGINEER
Salem, Oregon

CLAC
04817

Well Record

STATE WELL NO. 2/3-14L1
COUNTY MULTNOMAH
APPLICATION NO.


OWNER: Salvation Army

MAILING ADDRESS:
CITY AND STATE:

LOCATION OF WELL: Owner's No.

..... 1/4 1/4 Sec. T. N. E.
S., R. W., W.M.

Bearing and distance from section or subdivision corner

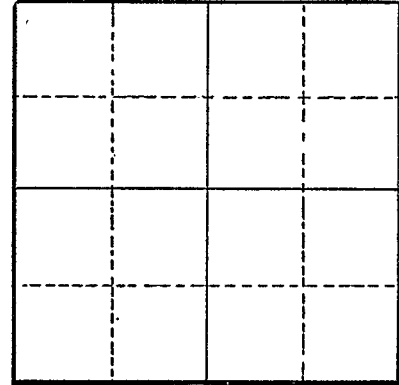

Section

Altitude at well 300

TYPE OF WELL: Drilled.. Date Constructed

Depth drilled 600 Depth cased 571

CASING RECORD:

8 inch

FINISH:

AQUIFERS:

Basalt, Columbia River basalt, from 575 to 600

WATER LEVEL:

Flowing well, 1951

PUMPING EQUIPMENT: Type

H.P.

Capacity G.P.M.

WELL TESTS:

Drawdown ft. after hours G.P.M.

Drawdown ft. after hours G.P.M.

USE OF WATER Public Supply

Temp. °F., 19.....

SOURCE OF INFORMATION USGS

DRILLER or DIGGER

ADDITIONAL DATA:

Log Water Level Measurements Chemical Analysis Aquifer Test

REMARKS:

Pumped 30 gpm, drawdown 200 feet after 1 hour.

