

STATE ENGINEER
Salem, Oregon

CLAC 5090 Well Record

STATE WELL NO. 2/3-24
COUNTY Clackamas
APPLICATION NO. GR-3474

OWNER: James L. Miller


MAILING ADDRESS: Route 3, Box 317A

LOCATION OF WELL: Owner's No.

CITY AND STATE: Boring, Oregon

SW 1/4 SW 1/4 Sec. 24 T. 2 N. S., R. 3 E. W., W.M.

Bearing and distance from section or subdivision corner

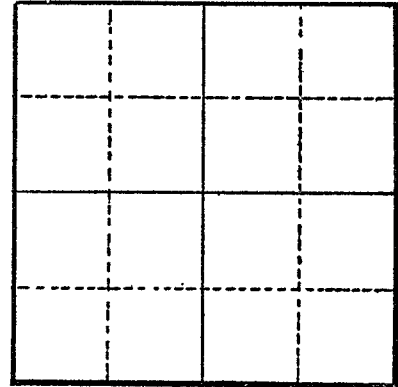

Section 24

Altitude at well

TYPE OF WELL: Drilled Date Constructed 1953

Depth drilled 25 Depth cased

CASING RECORD:

6 inch

FINISH:

Unknown

AQUIFERS:

Unknown

WATER LEVEL:

45 feet

PUMPING EQUIPMENT: Type Reda submersible H.P. 2
Capacity 24 G.P.M.

WELL TESTS:

Drawdown ft. after hours G.P.M.

Drawdown ft. after hours G.P.M.

USE OF WATER Irrigation Temp. °F. 19

SOURCE OF INFORMATION GR-3474

DRILLER or DIGGER

ADDITIONAL DATA:

Log Water Level Measurements Chemical Analysis Aquifer Test

REMARKS: