

STATE ENGINEER
Salem, Oregon

CLAC (5218) Well Record

STATE WELL NO. 2/3-290
COUNTY Clackamas
APPLICATION NO. GR-4202

OWNER: W. J. Jarvis & Leola Jarvis

MAILING
ADDRESS:

Route 5, Box 478

LOCATION OF WELL: Owner's No.

CITY AND
STATE:

Oregon City, Oregon

SW $\frac{1}{4}$ SE $\frac{1}{4}$ Sec. 29 T. 2 N. S., R. 3 E. W.M.


Bearing and distance from section or subdivision

corner 500' E. & 1170' N. of S $\frac{1}{4}$ Cor. Sec. 29

Altitude at well

TYPE OF WELL: Drilled Date Constructed 12/54

Depth drilled 110 ft. Depth cased 110 ft.

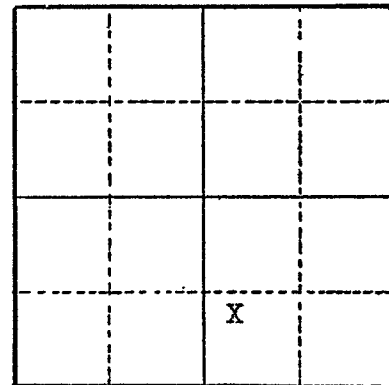

Section 29

CASING RECORD:

6 inch casing set to 110 ft. Hard steel shoe welded.

FINISH:

two 3/8" x 1" perforations from 60 to 70 feet

AQUIFERS:

WATER LEVEL:

40 feet below surface

PUMPING EQUIPMENT: Type 1 $\frac{1}{4}$ " submersible H.P. 3/4
Capacity 30 G.P.M.

WELL TESTS:

Drawdown ft. after hours 30 G.P.M.

Drawdown 30 ft. after hours 25 G.P.M.

USE OF WATER Irrigation Temp. °F., 19....

SOURCE OF INFORMATION Well Registration Statement Cert. # GR-3753

DRILLER or DIGGER A. O. Olsen

ADDITIONAL DATA:

Log Water Level Measurements Chemical Analysis Aquifer Test

REMARKS: