

STATE ENGINEER
Salem, Oregon

CLACC5244

Well Record

STATE WELL NO. 2/3-31C(1)
COUNTY Clackamas
APPLICATION NO. GR-224

OWNER: Edwin B. Olesen


MAILING ADDRESS: Route 5, Box 635

LOCATION OF WELL: Owner's No. #1

CITY AND STATE: Oregon City, Oregon

NE 1/4 NW 1/4 Sec. 31 T. 2 N. S. R. 3 E. W.M.

Bearing and distance from section or subdivision corner 1000 ft. S. & 950 ft. W. from N 1/4 Cor. Sec. 31

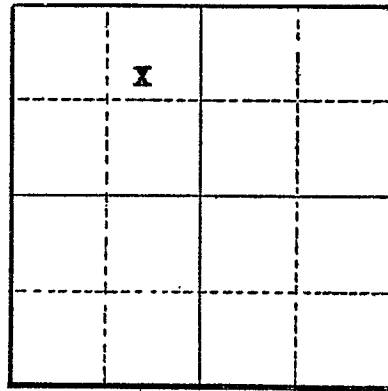

Section 31

Altitude at well 400 ft. Interpolated

TYPE OF WELL: Drilled Date Constructed 5/9/49

Depth drilled 79 ft. Depth cased 79 ft.

CASING RECORD: 6 inch casing set from 0 to 79 ft.

FINISH: none

AQUIFERS: Sand

WATER LEVEL: 24 ft. below land surface 6/30/49

PUMPING EQUIPMENT: Type Cook turbine H.P. 3
Capacity 40 G.P.M.

WELL TESTS:

Drawdown	37 1/2	ft. after	hours	pumping	18	G.P.M.
Drawdown	75	ft. after	hours	"	45	G.P.M.

USE OF WATER Irrigation 10 acres Temp. °F. 19

SOURCE OF INFORMATION Registration Statement GR-224

DRILLER or DIGGER Steinman Bros.

ADDITIONAL DATA:
Log No Water Level Measurements Chemical Analysis Aquifer Test

REMARKS: