

RECEIVED

FEB 4 - 1986

CLAC 05345 25/4E-16

STATE OF OREGON
WATER WELL REPORT
(as required by ORS 537.765)

WATER RESOURCES DEPT
SALEM, OREGON

(1) OWNER: Owner's Well Number: _____
Name Lyle Schoppert & Rhonda Schoppert
Address 41641 S. E. Allgerer Road
City Sandy State OR Zip 97055

(2) TYPE OF WORK:
☒ New Well ☐ Deepen ☐ Recondition ☐ Abandon

(3) DRILL METHOD:
☐ Rotary Air ☐ Rotary Mud ☒ Cable ☐ Other

(4) PROPOSED USE:
☒ Domestic ☐ Community ☐ Industrial ☐ Irrigation
☐ Thermal ☐ Injection ☐ Other

(5) BORE HOLE CONSTRUCTION:
Depth of Completed Well 127 ft.
Special Standards date of approval _____

HOLE	SEAL	Amount
Diameter From To	Material From To	sacks or pounds
6 inch 0 to 127	Bentonite 0 to 24	23 sacks

How was seal placed? Method ☐ A ☐ B ☐ C ☐ D ☐ E
☐ Other

Backfill placed from _____ ft. to _____ ft. Material _____
Gravel placed from 24 ft. to 127 ft. Size of gravel 3/8 minus

(6) CASING/LINER:

Diameter	From	To	Gauge	Steel	Plastic	Welded	Threaded
Casing: 6-inch	+1	127	.250	☐	☒	☐	☐
Liner:				☐	☐	☐	☐

Final location of shoe(s) _____

(7) PERFORATIONS/SCREENS:
☒ Perforations Method Saw
☐ Screens Type _____ Material _____

From	To	Slot size	Number	Diameter	Tele/pipe size	Casing	Liner
3	126	1/8	112			☒	☐

(8) WELL TESTS: Minimum testing time is 1 hour
☐ Pump ☒ Bailer ☐ Air ☐ Flowing Artesian
Yield gal/min 18 gpm Pumping level 110 feet Drill stem at _____ Time 1/2 hr
18 gpm 110 feet _____ 1 hr


Temperature of water 53° Depth Artesian Flow Found _____
Was a water analysis done? ☐ Yes By whom _____
Did any strata contain water not suitable for intended use? ☐ Too little
☐ Salty ☐ Muddy ☐ Odor ☐ Colored ☐ Other _____
Depth of strata: _____

(9) LOCATION OF WELL by legal description:
County Clack. Latitude _____ Longitude _____
Township 2-South N or S, Range 1-East E or W, WM.
Section 1 1/4 N.W. 1/4
Tax Lot _____ Lot _____ Block _____ Subdivision _____
Street Address of Well (or nearest address) _____

(10) STATIC WATER LEVEL:
103 ft. below land surface. Date 1-15-86
Artesian pressure _____ lb. per square inch. Date _____

(11) WELL LOG: Ground elevation _____

Material	From	To	WB?	SWL
Clay; brown	0	27		
Boulders	27	29		
Cemented gravel & Boulders	29	44		
Clay; brown	44	63		
Shale; gray	63	91		
Clay; blue-gray	91	99		
Clay; sandy, gray-brown	99	104		
Sandstone; gray	104	118	18gpm	103
Clay; blue	118	123		
Clay; blue-gray	123	127		

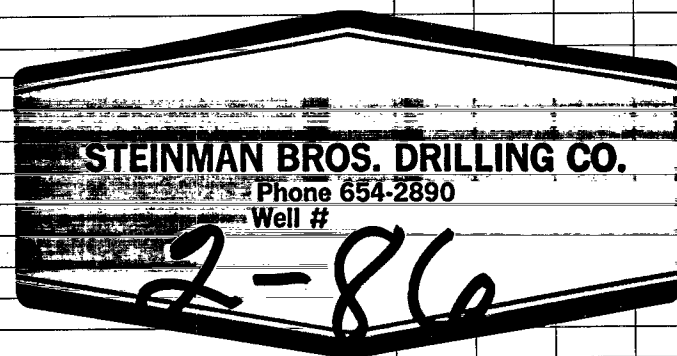

Date started 1-10-86 Completed 1-15-86

(unbonded) Water Well Constructor Certification:
I constructed this well in compliance with Oregon well construction standards. Materials used and information reported above are true to my best knowledge and belief.

Signed _____ Date _____

(bonded) Water Well Constructor Certification:

I accept responsibility for construction of this well and its compliance with all Oregon water well standards. This report is true to the best of my knowledge and belief.

Signed Ronald F. McConnell Date 1-20-86

Ronald F. McConnell

Company Steinman Bros. Drilling Co. Job No. 2-86

Oregon Water Constructor's License #1