

NOTICE TO WATER WELL CONTRACTOR
The original and first copy of this report
are to be filed with the

WATER RESOURCES DEPARTMENT
SALEM, OREGON 97310
within 30 days from the date
of well completion.

WATER WELL REPORT

STATE OF OREGON MAR 30 1979

State Well No. 23/4E-4

(Please type or print)
WATER RESOURCES DEPT. Permit No. _____
SALEM, OREGON

CLACK
5444

(1) OWNER: (J. Frank Schmidt Nursery)

Name Homebuilders Investment & Supply, Inc
Address 855 E. Burnside
Portland, Oregon 97030

(2) TYPE OF WORK (check):

New Well Deepening Reconditioning Abandon
If abandonment, describe material and procedure in Item 12.

(3) TYPE OF WELL:

Rotary Driven
Cable Jetted
Dug Bored

(4) PROPOSED USE (check):

Domestic Industrial Municipal
Irrigation Test Well Other

(5) CASING INSTALLED:

Threaded Welded
12" Diam. from +4 ft. to 281 1/2 ft. Gage .330
12" drive shoe 281 1/2 ft. to 282 ft. Gage _____
" Diam. from _____ ft. to _____ ft. Gage _____

(6) PERFORATIONS:

Perforated? Yes No.

Type of perforator used _____

Size of perforations in. by in.
_____ perforations from _____ ft. to _____ ft.
_____ perforations from _____ ft. to _____ ft.
_____ perforations from _____ ft. to _____ ft.

(7) SCREENS:

Well screen installed? Yes No

Manufacturer's Name _____
Type _____ Model No. _____
Diam. _____ Slot size _____ Set from _____ ft. to _____ ft.
Diam. _____ Slot size _____ Set from _____ ft. to _____ ft.

(8) WELL TESTS:

Drawdown is amount water level is lowered below static level

Was a pump test made? Yes No If yes, by whom? SEI
Yield: gal./min. with ft. drawdown after hrs.
See attached sheet " " "
" " " "
Bailer test gal./min. with ft. drawdown after hrs.
Artesian flow g.p.m.

Temperature of water _____ Depth artesian flow encountered _____ ft.

(9) CONSTRUCTION:

neat cement grout w/ 2% bentonite & 5 gal H₂O per sack
Well seal—Material used _____
Well sealed from land surface to 38'8" ft.
Diameter of well bore to bottom of seal 16 in.
Diameter of well bore below seal 12 in.
Number of sacks of cement used in well seal 95 sacks
How was cement grout placed? pumped from bottom of annular space upward as 16" surface casing was pulled.

Was a drive shoe used? Yes No Plugs _____ Size: location _____ ft.
Did any strata contain unusable water? Yes No
Type of water? _____ depth of strata _____
Method of sealing strata off _____
Was well gravel packed? Yes No Size of gravel: _____
Gravel placed from _____ ft. to _____ ft.

RECEIVED

(10) LOCATION OF WELL:

County Clackamas Driller's well number 7901
1/4 1/4 Section 4 T. 2S R. 4E W.M.
Bearing and distance from section or subdivision corner _____

(11) WATER LEVEL: Completed well.

Depth at which water was first found 0 ft.
Static level 161 1/2 ft. below land surface. Date 3-19-79
Artesian pressure _____ lbs. per square inch. Date _____

(12) WELL LOG:

Diameter of well below casing _____
Depth drilled 405 ft. Depth of completed well 405 ft.

Formation: Describe color, texture, grain size and structure of materials; and show thickness and nature of each stratum and aquifer penetrated, with at least one entry for each change of formation. Report each change in position of Static Water Level and indicate principal water-bearing strata.

MATERIAL	From	To	SWL
See sheet attached			
*See attached letter to and from Water Resources Dept. Note: Although it is extremely doubtful that any additional future work would be required on the well, considering the contract for constructing the well was on a time and material basis, Schneider Equipment, Inc. cannot be held liable for any future work on the well without just and reasonable compensation for the performance of any such work.			

Work started 11-16 1978 Completed 3-22 1979
Date well drilling machine moved off of well 3-20 1979

Drilling Machine Operator's Certification:

This well was constructed under my direct supervision. Materials used and information reported above are true to my best knowledge and belief.
[Signed] Donald E. Davis Date 3-27, 1979
(Drilling Machine Operator)
Drilling Machine Operator's License No. 1085

Water Well Contractor's Certification:

This well was drilled under my jurisdiction and this report is true to the best of my knowledge and belief.
Name Schneider Equipment, Inc.
(Firm, firm or corporation) (Type or print)
Address 2188 1/2 River Rd NE, St. Paul, Ore. 97137
[Signed] Stephen J. Schneider
(Water Well Contractor)
Contractor's License No. 649 Date 3-27, 1979

Homebuilders Investment & Supply, Inc.

Material	From	To
Top soil, brown	0	2
Clay, red	2	11
Clay, red & gray w/ rocks conglomerate	11	21
Gravel up to 6"	21	28
Gravel w/ some clay, light brown	28	30
Sand, coarse and gravel	30	35
Sand & gravel w/ signs of clay	35	40
Sand & some gravel w/ clay	40	48
Sand, clay & gravel conglomerate	48	58
Sand, clay & pea gravel conglomerate	58	62
Clay, green w/ some sand & pea rock	62	77
Clay, green and gray w/ some sand & gravel	77	79
Sand & gravel w/ some clay	79	84
Sand & gravel up to 1"	84	88
Gravel, cemented w/ clay	88	109
Clay, light brown, silty	109	112
Clay, light brown, fine sandy	112	124
Clay, light brown, with some gravel	124	132
Clay, light brown, fine-medium sandy	132	145
Clay, light brown, fine-medium sandy w/ some gravel	145	182
Clay, brown w/ some coarse sand cemented	182	190
Clay, brown	190	207
Sand & gravel cemented, w/ some clay	207	216
Sand & gravel loosely cemented	216	224
Gravel & sand	224	231
Clay, gravel & sand, brown, conglomerate	231	234
Clay, brown, hard	234	238
Clay, brown	238	240
Sand, brown w/ clay & pea gravel	240	244
Clay, light brown w/ gravel, cemented	244	247
Sand, brown, medium coarse w/ some clay	247	250
brown	247	250
Sand, brown med. coarse w/ clay, brown	250	254
Sand, brown medium	254	258
Sand, black coarse	258	267
Sand, black, med. coarse w/ some clay,	267	270
gray	267	270
Sand, black, med. coarse	270	272
Clay, dark gray & dark green streaked	272	282
gritty	272	282
Basalt, black hard	282	289
Basalt, fractured w/ clay	289	314
Basalt, fractured medium hard w/ occasional gravel layers	314	405

SWL

unknown →

↓

unknown

↓

142

↑

unknown


↓

164 1/2


164 1/2

164 1/2

Existing Condition

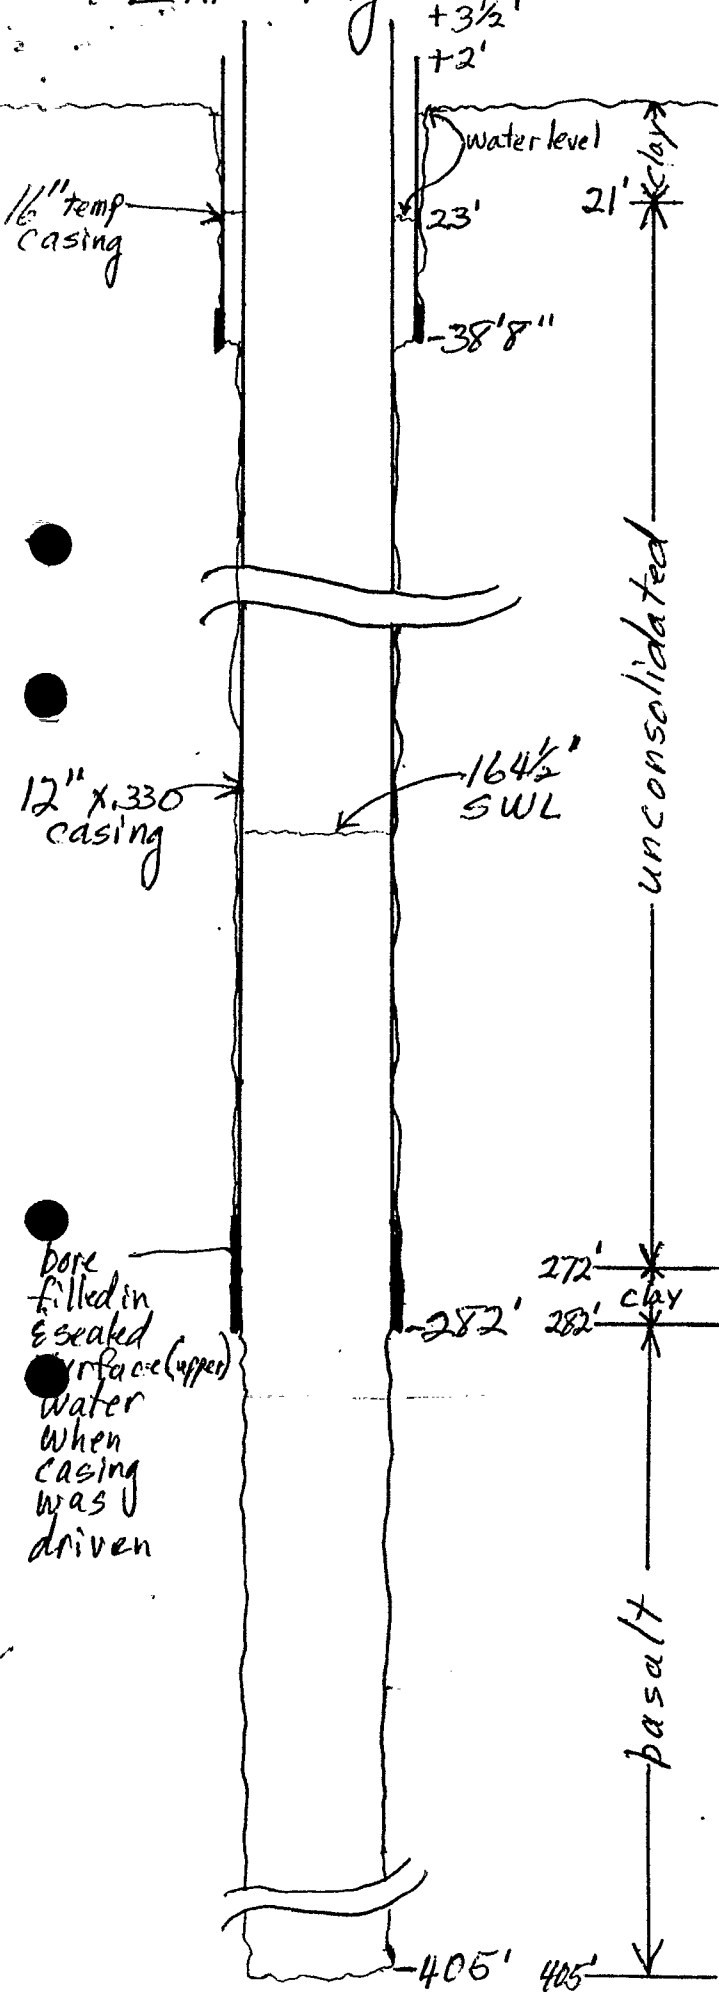

Proposed Final Condition

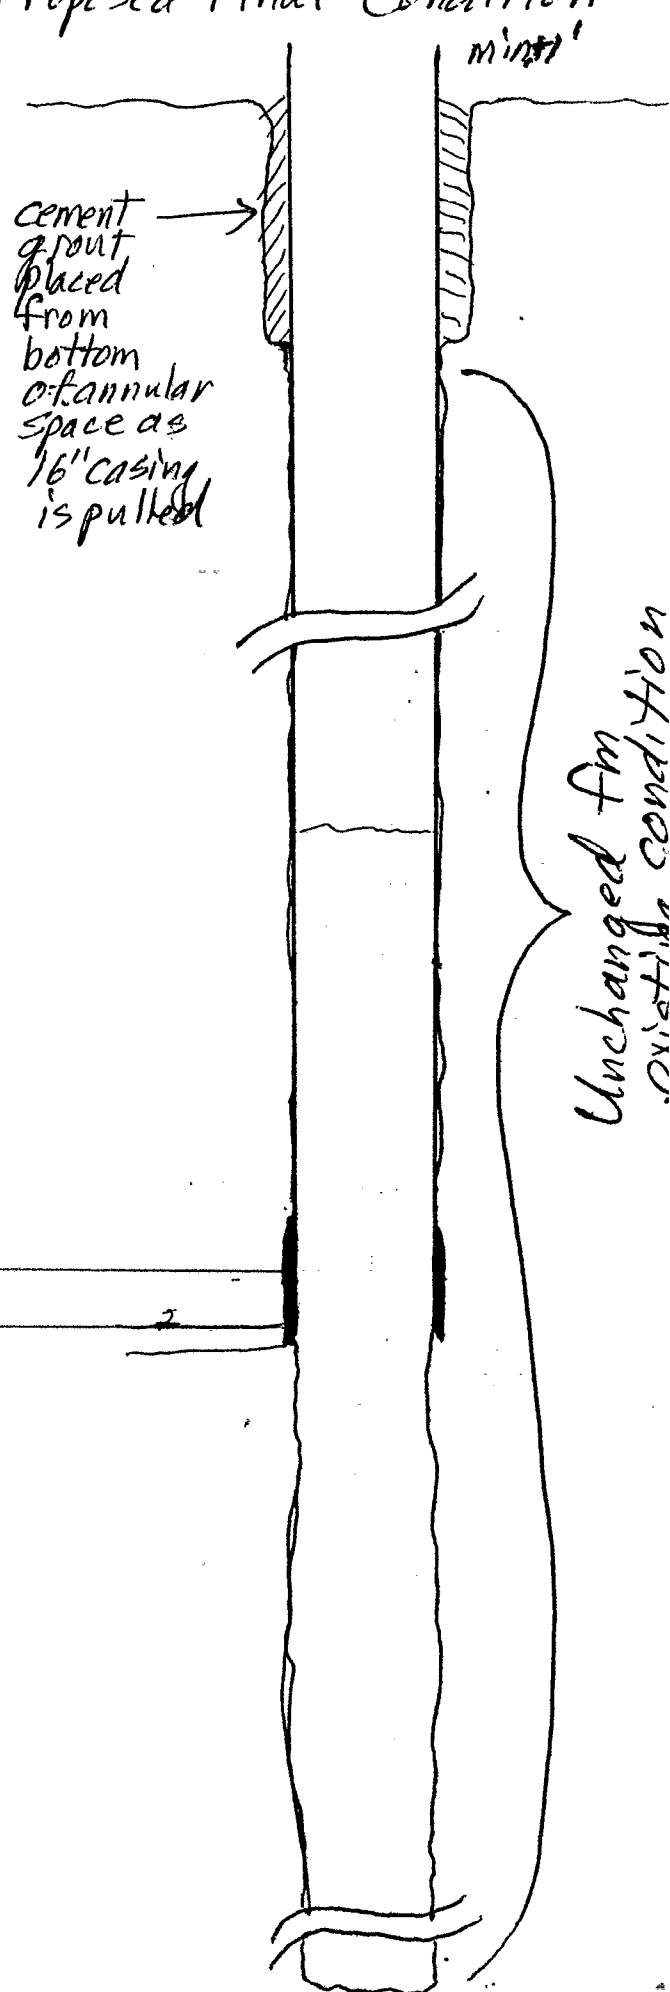

Well Construction Summary

0 - 238 Static approximately 0 because of surface water

Drove casing to 225'6" - bailed hole - bail bucket stuck set for 4 days - static 142' - blew bail bucket loose - static came back to surface

Drilled to 282' - cased to 275' - Static 15' but over weekend filled back to surface


Drilled to 304' - drove casing to 282' - casing stopped - Static stayed at surface

Drilled to 405' - Static at 0

Had 354' of hole on Monday A.M. - tried to drive casing 3/4 hour - did not move casing

Set air lift (6" & 2") at 303' - Static 0 - Started air -
Static went 0 to 164'6" - 500+ gpm - 176'6" PL
Next day Static went to 164'6" 179' PL
2-22-79 Static 164'6"
Between casing 23'
Outside 16" 0

Has 40'8" of 16" casing - 38'8" below ground
285'6" of 12" +3'6" to 282' - no drilling since

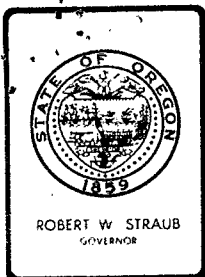

Water Resources Department

MILL CREEK OFFICE PARK

555 13th STREET N.E., SALEM, OREGON 97310

PHONE 378-8455

March 9, 1979

Milo Schneider
Schneider Equipment, Inc.
21881 River Rd. NE
St. Paul, Oregon 97137


Dear Mr. Schneider:

This is to acknowledge receipt of your request for special standards for the Homebuilder's Investment and Supply, Inc. well located in Section 4, Township 2 South, Range 4 East. The well log describing the construction of the well reports that 282 feet of 12-inch diameter casing was placed in the well to a depth of 282 feet. Basalt rock was reportedly encountered at this depth, overlain by 10 feet of clay. Your observation of air tests within the well reportedly confirmed to you that the casing provided a "shoe cut-off" between the upper sedimentary rocks and the basaltic aquifer system.

You are hereby granted special standards to construct the aforesaid well in accordance with your written report. The 12-inch casing is to be sealed to a depth of 38 feet 8-inches as the 16-inch temporary casing is removed.

Should it become evident at some future date that the well, by the nature of its construction is a source of contamination or waste of the ground water, it will become necessary for you to return to the well site to correct all well deficiencies.

Sincerely,


WILLIAM B. MCCALL
Hydrogeologist

WBM:clh

cc: Cliff King, Watermaster, District #16