

STATE ENGINEER
Salem, Oregon

CLAC
Now O. FUNK 05478

OBSERVATION WELL
Well Record

STATE WELL NO. 2/4-4R(1)
COUNTY Clackamas
APPLICATION NO. GR-1120

GR- 1080

OWNER: M. K. Smith

MAILING ADDRESS: Rt. 1, Box 77


LOCATION OF WELL: Owner's No. _____

CITY AND STATE: Boring, Oregon

SE 1/4 SE 1/4 Sec. 4 T. 2 S., R. 4 W., W.M.

Bearing and distance from section or subdivision
corner N36°30'W. 975' from SE cor. of Sec. 4.

Altitude at well 690 ft.

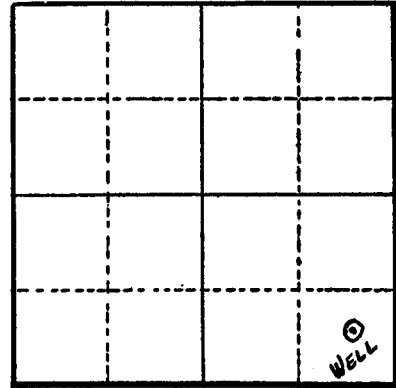

Section 4

TYPE OF WELL: Drilled Date Constructed 1951

Depth drilled 400 ft. Depth cased 400 ft.

CASING RECORD:

- 8 inch from 0 to 247 ft.
- 6 inch from 280 to 400 ft.

FINISH:

AQUIFERS:

GRAVEL, TROUTDALE FORMATION

WATER LEVEL:

93.5' (3-13-58)

PUMPING EQUIPMENT: Type 3" Submersible turbine H.P. 15
Capacity 120 G.P.M.

WELL TESTS:

Drawdown 215 ft. after _____ hours 60 G.P.M.
Drawdown _____ ft. after _____ hours _____ G.P.M.

USE OF WATER Irrigation Temp. _____ °F., 19____

SOURCE OF INFORMATION G. R. Record

DRILLER or DIGGER Jaansen Drilling Co.

ADDITIONAL DATA:

Log Water Level Measurements _____ Chemical Analysis _____ Aquifer Test _____

REMARKS:

Irrigation of 33 acres.

