

STATE ENGINEER
Salem, Oregon

CLAC
C5536

Well Record

STATE WELL NO. 2/4-5A
COUNTY Clackamas
APPLICATION NO. GR-3097

OWNER: Glen J. Tuttle


MAILING ADDRESS: Route 1, Box 47

LOCATION OF WELL: Owner's No. _____

CITY AND STATE: Boring, Oregon

NE $\frac{1}{4}$ NE $\frac{1}{4}$ Sec. 5 T. 2 ^{N.} S., R. 4 ^{E.} W., W.M.

Bearing and distance from section or subdivision corner 700 ft. S. and 1250 ft. E.

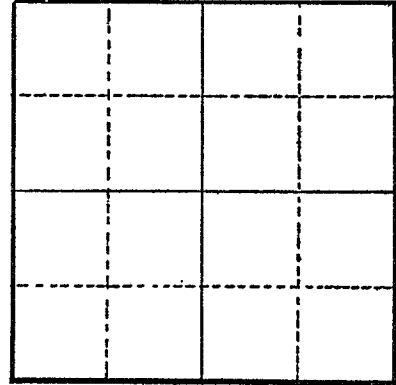

Section _____

Altitude at well _____

TYPE OF WELL: Drilled Date Constructed 1951

Depth drilled 170 feet Depth cased _____

CASING RECORD:

FINISH:

from 74 to 80
from 118 to 124

AQUIFERS:

Clay, boulders, gravel, rock

WATER LEVEL:

80 feet

PUMPING EQUIPMENT: Type Western Land Roller turbine H.P. 1-20
Capacity 150 G.P.M.

WELL TESTS:

Drawdown 80 ft. after _____ hours _____ Pumping 150 G.P.M.
Drawdown 89 ft. after _____ hours _____ Pumping 155 G.P.M.

USE OF WATER Irrigation Temp. _____ °F., 19 _____

SOURCE OF INFORMATION GR-2905

DRILLER or DIGGER _____

ADDITIONAL DATA:

Log Water Level Measurements _____ Chemical Analysis _____ Aquifer Test _____

REMARKS:

Yellow clay	1	7	6
Boulders and gravel	7	74	67
Gravel with a little water	74	80	6
Cement gravel	80	118	38
Gravel with more water	118	124	6
Cement gravel	124	152	28
Yellow and blue clay	152	278	126
Rock	278	288	10
Blue Clay	288	300	12