

STATE ENGINEER
Salem, Oregon

CLAC 05537

Well Record

STATE WELL NO. 2/4-5K
COUNTY Clackamas
APPLICATION NO. GR-1612

GR-1568

OWNER: Merlen C. Malar


MAILING ADDRESS: Rt. 1, Box 483

LOCATION OF WELL: Owner's No. _____

CITY AND STATE: Boring, Oregon

NW ¼ SE ¼ Sec. 5 T. 2 S., R. 4 XX W.M.

Bearing and distance from section or subdivision corner 700' S. & 370' E. from NW cor. SE ¼ of Sec. 5

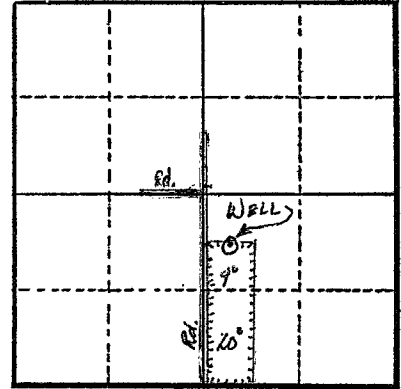

Section 5

Altitude at well _____

TYPE OF WELL: Drilled Date Constructed 1950

Depth drilled 128' Depth cased 128'

CASING RECORD:

8"

FINISH:

Perforated: 2 rows of 1 1/4" x 3/16" (6/ft.) from 95 to 125 ft.

AQUIFERS:

WATER LEVEL:

95 ft.

PUMPING EQUIPMENT: Type Western turbine H.P. 10
Capacity 300 G.P.M.

WELL TESTS:

Drawdown 85 ft. after _____ hours 120 G.P.M.
Drawdown 65 ft. after _____ hours 80 G.P.M.

USE OF WATER Irrigation Temp. _____ °F., 19

SOURCE OF INFORMATION GR Record

DRILLER or DIGGER A. O. Olsen

ADDITIONAL DATA:

Log _____ Water Level Measurements _____ Chemical Analysis _____ Aquifer Test _____

REMARKS:

Log: Clay & gravel 0 to 45 ft.
Cement gravel 45 to 95 ft.
Loose gravel & cement 95 to 128 ft. (water)

Irrigation of 29 acres.