


ORIGINAL – WATER RESOURCES DEPARTMENT FIRST COPY – CONSTRUCTOR SECOND COPY – CUSTOMER

KRAXBERGER WELL TEST on 8/9/00

RECEIVED

DEC 26 2000

WATER RESOURCES DEPT
SALEM, OREGON

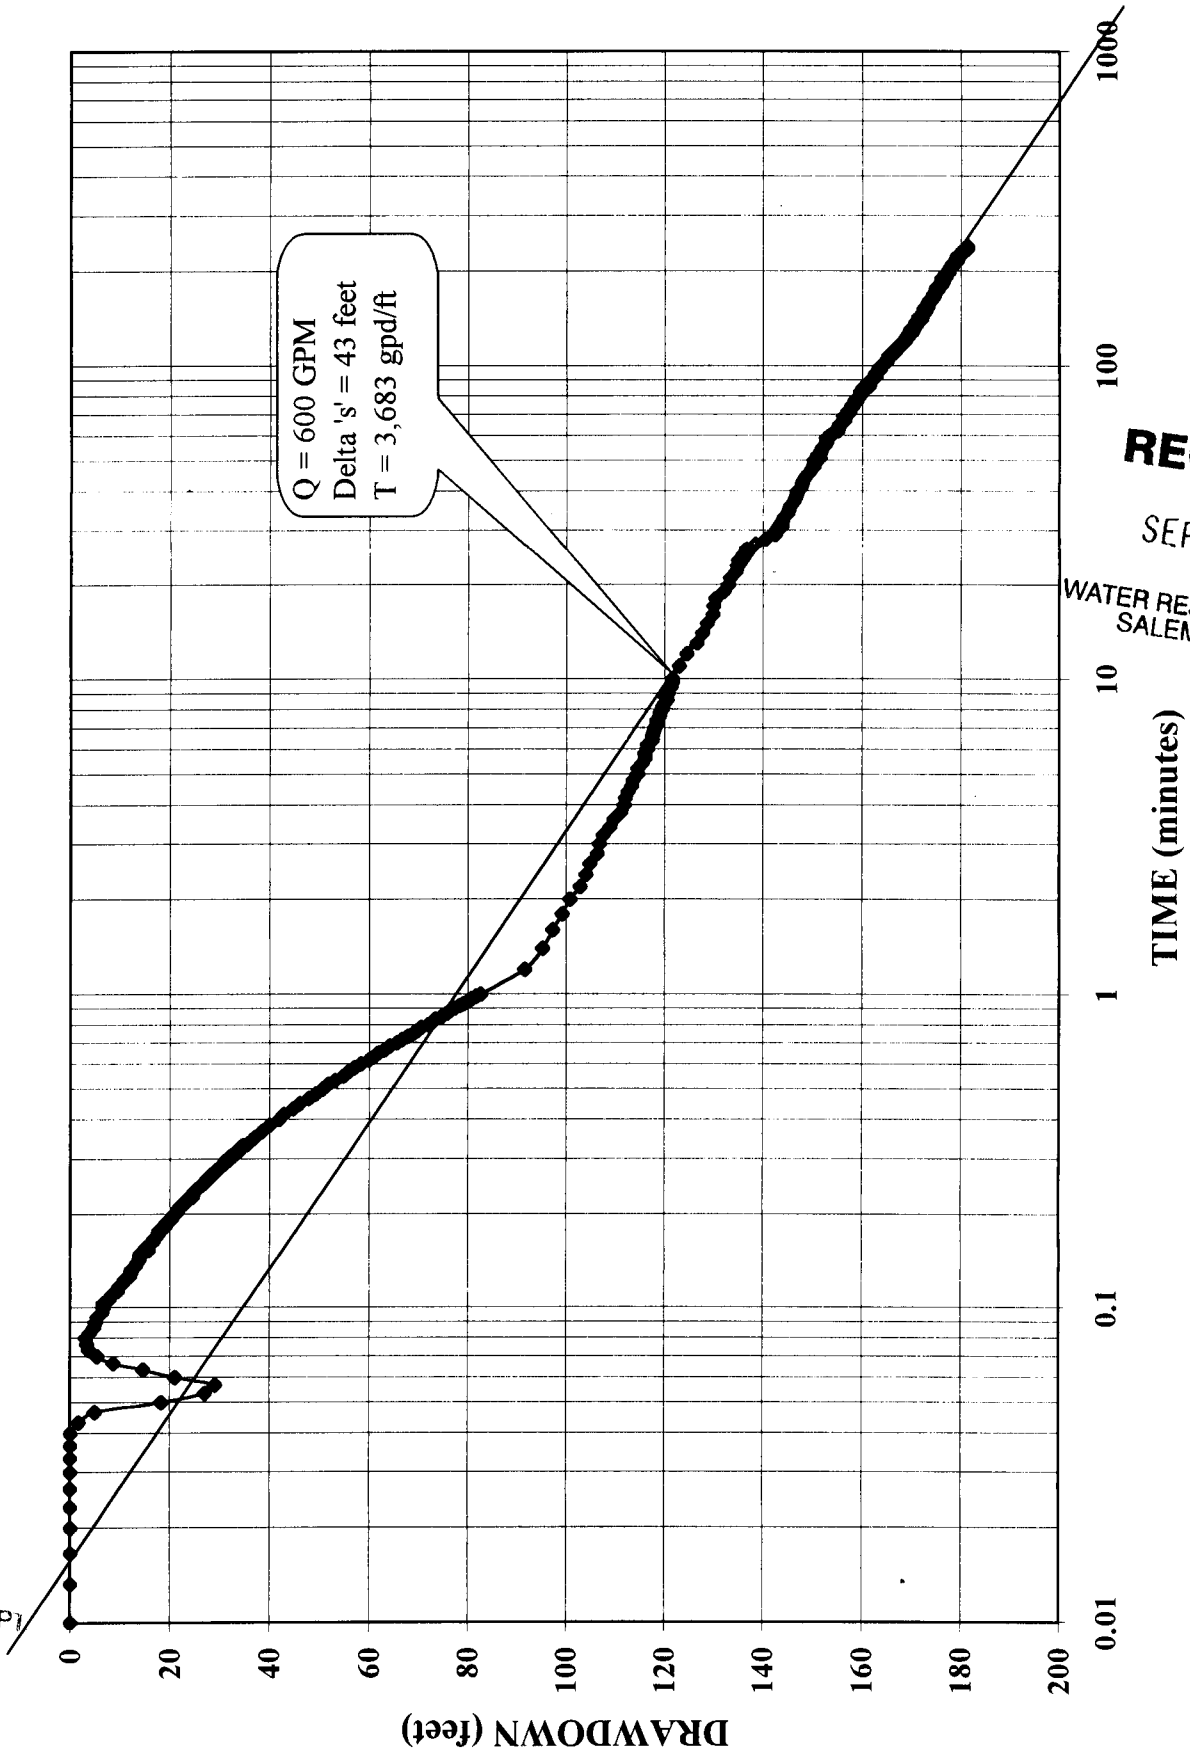

RECEIVED

SEP 01 2000

WATER RESOURCES DEPT
SALEM, OREGON

Schneider Drilling Co.

KRAXBERGER RECOVERY beginning 8/9/00

RECEIVED


SEP 01 2000

WATER RESOURCES DEPT.
SALEM, OREGON

TIME (minutes)

RESIDUAL DRAWDOWN (feet)

Delta 's' = 43 feet

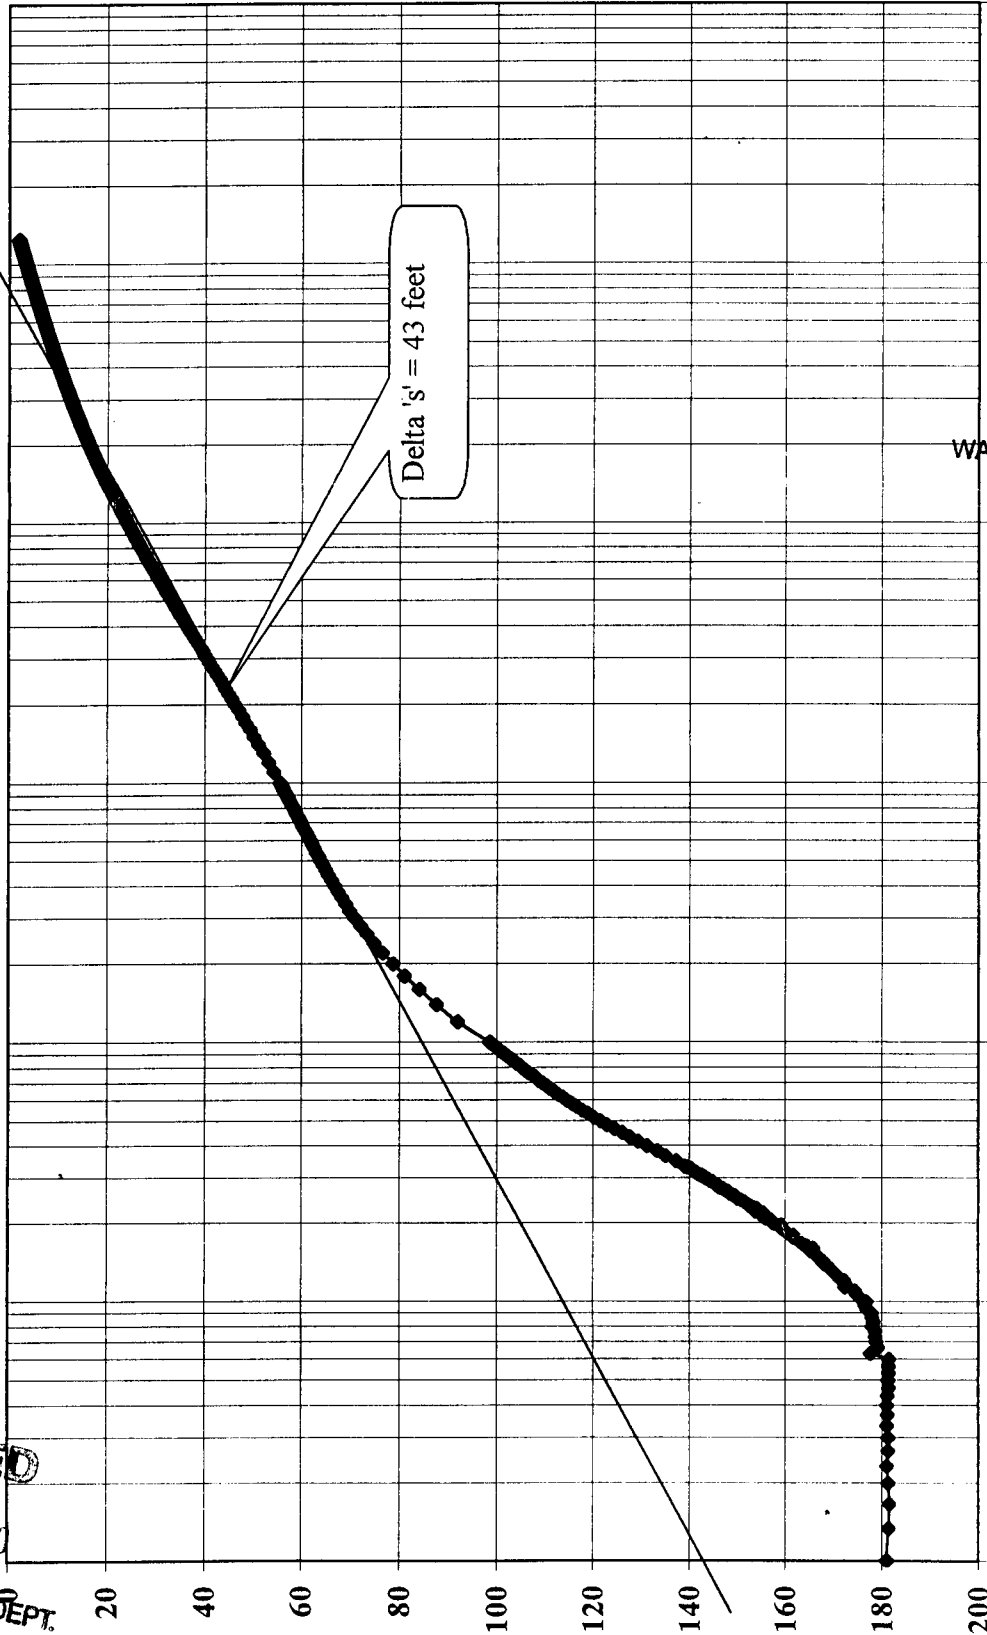

RECEIVED

DEC 26 2000

WATER RESOURCES DEPT.
SALEM, OREGON

Kraxberger test data & graphs CR rec graph

Kraxberger, Alan
by Schneider Drilling Co.

Start Card # 127598

Label #33775

<u>FM</u>	<u>TO</u>	<u>DESCRIPTION</u>
0	2	Topsoil
2	21	Clay, brown, medium
21	41	Sand, brown, medium course
41	46	Gravel, pea, Sand, brown, Clay, brown
46	51	Clay, brown w/ some gravel
51	56	Clay, brown
56	61	Clay, grey
61	76	Sand, brown, medium & gravel, small
76	91	Gravel, 1/2"- & sand, brown, medium-coarse
91	101	Clay, green-grey & gravel, 1/2"-
101	106	Sand, grey, coarse & gravel, pea
106	111	Clay, grey, medium w/some hard
111	116	Clay, blue, sandy, medium w/some hard
116	121	Sand, blue-grey w/clay, tan, medium
121	126	Gravel, pea w/ sand, coarse, some cementation
126	131	Sand, blue-grey, coarse, w/cementation
131	141	Clay, tan, medium w/hard
141	191	Clay, grey w/ some brown, medium w/some hard
191	201	Clay, blue-grey, silty-sandy, medium w/hard
201	211	Clay, grey w/gravel, pea & sand, coarse
211	226	Clay, grey, medium w/some hard
226	231	Clay, grey w/gravel, pea & sand, coarse
231	281	Clay, grey, medium w/some hard
281	286	Gravel, pea & sand, coarse w/ some clay
286	296	Gravel, pea & sand, coarse
296	301	Gravel, pea & sand, coarse w/some clay
301	306	Clay, grey-brown, sandy, medium w/ some hard
306	316	Clay, grey, medium w/hard
316	326	Clay, grey, hard
326	401	Clay, grey, medium w/ occasional hard

RECEIVED

SEP 01 2000

WATER RESOURCES DEPT.
SALEM, OREGON**RECEIVED**

DEC 26 2000

WATER RESOURCES DEPT.
SALEM, OREGON