

STATE ENGINEER
Salem, Oregon

CLAC
05615

Well Record


STATE WELL NO. 2/4-70(1)
COUNTY Clackamas
APPLICATION NO. GR-245

OWNER: Glen T. Schaeffer
MAILING ADDRESS: Route 3, Box 225A

LOCATION OF WELL: Owner's No. #1
CITY AND STATE: Boring, Oregon

NE 1/4 NW 1/4 Sec. 7 T. 2 N. S., R. 4 E. W., W.M.

Bearing and distance from section or subdivision
corner 2100' North & 510' West of center
of Section 7, T. 2 S., R. 4 E.

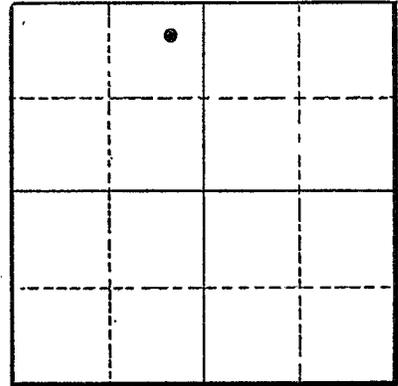

Section 7

Altitude at well 600' Interpolated

TYPE OF WELL: Drilled Date Constructed June 51

Depth drilled 259' Depth cased 259'

CASING RECORD:

12-inch casing set from 0 to 259 feet

FINISH:

16 perforations per foot (3/8" x 1 1/4") from 230 to 252 feet

AQUIFERS:

Gravels from 227 to 258 feet

WATER LEVEL:

170 feet below land surface

PUMPING EQUIPMENT: Type Western Land Roller H.P. 40
Capacity 800 G.P.M.

WELL TESTS:

Drawdown 8 ft. after 1500 hours G.P.M.
Drawdown ft. after hours G.P.M.

USE OF WATER Irrigation 106 acres Temp. °F., 19

SOURCE OF INFORMATION Registration Statement GR-245

DRILLER or DIGGER

ADDITIONAL DATA:

Log yes Water Level Measurements Chemical Analysis Aquifer Test

REMARKS:

