

CLAC
57153

STATE OF OREGON
WATER SUPPLY WELL REPORT

(as required by ORS 537.765)

WELL I.D. # L 33801

START CARD # ~~38419~~ 138419

Instructions for completing this report are on the last page of this form.

(1) LAND OWNER Well Number _____
Name Oregon City School District
Address 1417 12th Street
City Oregon City State OR Zip 97045

(2) TYPE OF WORK
 New Well Deepening Alteration (repair/recondition) Abandonment

(3) DRILL METHOD:
 Rotary Air Rotary Mud Cable Auger
 Other Reverse Circulation Rotary

(4) PROPOSED USE:
 Domestic Community Industrial Irrigation
 Thermal Injection Livestock Other _____

(5) BORE HOLE CONSTRUCTION:
Special Construction approval Yes No Depth of Completed Well 1019ft.
Explosives used Yes No Type _____ Amount _____

HOLE			SEAL			Sacks or pounds
Diameter	From	To	Material	From	To	
16	0	20	Bentonite	0	18	24 sacks
15	20	710	Cement	18	700	405 sacks
10	710	1022				

How was seal placed: Method A B C D E
 Other Bentonite Poured & Probed

Backfill placed from _____ ft. to _____ ft. Material _____
Pack placed from 648 ft. to 1000± ft. Size: ~~06XXX~~ CSSI 10x20

(6) CASING/LINER:

Diameter	From	To	Gauge	Steel	Plastic	Welded	Threaded
Casing: 10	+2	700	.250	<input checked="" type="checkbox"/>	<input type="checkbox"/>	<input checked="" type="checkbox"/>	<input type="checkbox"/>
Liner: 6	648	1022	.250	<input checked="" type="checkbox"/>	<input type="checkbox"/>	<input checked="" type="checkbox"/>	<input type="checkbox"/>

except @ screens

Drive Shoe used Inside Outside None
Final location of shoe(s) _____

(7) PERFORATIONS/SCREENS:
 Perforations Method _____
 Screens Type V shape wire wrap Material 304 SS

From	To	Slot size	Number	Diameter	Tele/pipe size	Casing	Liner
*	*	.030	Cont.	6	PS	<input type="checkbox"/>	<input type="checkbox"/>

(8) WELL TESTS: Minimum testing time is 1 hour
 Pump Bailer Air Artesian
Yield gal/min _____ Drawdown _____ Drill stem at _____ Time 1 hr.
See Attached Graphs

Temperature of water ~ 60°F Depth Artesian Flow Found _____
Was a water analysis done? Yes By whom _____
Did any strata contain water not suitable for intended use? Too little
 Salty Muddy Odor Colored Other _____
Depth of strata: _____

(9) LOCATION OF WELL by legal description:
County Clackamas Latitude _____ Longitude _____
Township 3S N or S Range 2E E or W. WM.
Section 9 NE 1/4 SE 1/4
Tax Lot 1300 Lot _____ Block _____ Subdivision _____
Street Address of Well (or nearest address) 19761 S. Beaver Creek Rd. Oregon City, OR 97045

(10) STATIC WATER LEVEL:
_____ 323 ft. below land surface. Date 8-7-01
Artesian pressure _____ lb. per square inch Date _____

(11) WATER BEARING ZONES:
Depth at which water was first found indeterminate

From	To	Estimated Flow Rate	SWL
See Screen Locations below 700'		See (8)	See (10)

RECEIVED
DEC 27 2001

(12) WELL LOG: Ground Elevation WATER RESOURCES DEPT. SALEM, OREGON

Material	From	To	SWL
See Attached Log			
*Screen Locations:			
	689	695	
	715	735	
	746	767	
	799	840	
	870	896	
	915	946	
	991	1002	
Clay Slough (cave back)	1000±	1022	

RECEIVED
AUG 24 2001
WATER RESOURCES DEPT SALEM, OREGON


Date started 6-15-01 Completed 8-7-01

(unbonded) Water Well Constructor Certification:
I certify that the work I performed on the construction, alteration, or abandonment of this well is in compliance with Oregon water supply well construction standards. Materials used and information reported above are true to the best of my knowledge and belief.
Signed _____ WWC Number 1578 Date 8-24-01


(bonded) Water Well Constructor Certification:
I accept responsibility for the construction, alteration, or abandonment work performed on this well during the construction dates reported above. All work performed during this time is in compliance with Oregon water supply well construction standards. This report is true to the best of my knowledge and belief.
Signed _____ WWC Number 649 Date 8-24-01

Oregon City School District--Moss Campus Well(s)**by Schneider Drilling Co.****Start Card # 38419 Label # 33801**


FM	TO	DESCRIPTION
0	2	Top Soil
2	17	Clay, brown, med-soft, gravel
17	20	Clay, grey, brown, soft, sandy, gravel
20	31	Rock, grey, medium
31	38	Clay, brown, medium
38	55	Claystone, brown, medium
55	57	Sand, brown, medium, cemented
57	61	Claystone, brown, medium
61	65	Clay, grey, soft, sandy
65	73	Sand, brown, coarse, cemented
73	80	Sand, green, coarse, cemented
80	85	Clay, brown, soft, silty
85	165	Clay, grey, soft, silty
165	173	Clay, blue, soft, claystone
173	230	Clay, blue-green, medium-soft, claystone
230	234	Claystone, blue-green, medium, sandy
234	241	Clay, grey, soft
241	251	Clay, blue, soft & some claystone
251	266	Clay, grey, soft
266	306	Clay, blue-grey, soft
306	406	Clay, blue, soft
406	416	Clay, grey, soft
416	428	Clay, grey, soft, sandy
428	432	Gravel, pea & sand, coarse w/wood & clay
432	470	Clay, grey, soft
470	550	Clay, blue & grey, soft
550	570	Clay, grey & blue, claystone, grey, soft
570	600	Clay & claystone, grey & blue, soft-medium
600	610	Clay & claystone, grey & blue w/ gravel, small
610	670	Clay, grey, & blue, soft
670	700	Clay, blue & grey, soft, silty
700	710	Clay & claystone, blue & grey, soft, silty
710	716	Clay & claystone, blue-grey, soft
716	721	Sand, black, fine, cemented medium
721	724	Clay, grey, silty, sandy, soft

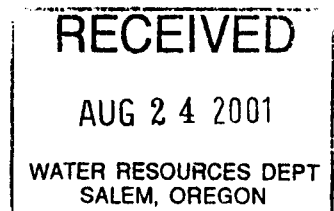

724 731 Clay, blue-green, silty, medium-hard
 731 734 Clay, blue-green, hard
 734 735 Clay, grey, sandy, medium
 735 737 Sand, black, medium, cemented hard
 737 739 Sand, grey-brown, medium, cemented hard & some wood
 739 740 Clay, grey, silty, medium-hard
 740 748 Clay, brown, sandy, medium
 748 750 Sand, black, medium, cemented
 750 751 Clay, brown, sandy
 751 757 Sand, black, medium & gravel, pea w/clay, grey-brown, sandy
 757 759 Clay, blue-grey, sandy, medium
 759 764 Sand & gravel ,grey, cemented w/ some clay, grey-brown
 764 768 Clay, grey-brown, sandy w/ gravel, pea
 768 772 Clay, brown, medium, silty
 772 774 Clay, blue-green, medium
 774 776 Clay, grey, medium, silty
 776 778 Clay, brown, medium, silty
 778 782 Clay, grey, medium, silty
 782 784 Sand, brown, cemented w/ wood
 784 787 Clay, brown, medium, silty/sandy
 787 788 Sand, black, medium, cemented
 788 790 Clay, brown, medium, sand-silty w/layers of sand, cemented, med
 790 793 Clay, grey, medium
 793 795 Clay, blue-grey, sandy, medium
 795 797 Clay, grey, sandy, w/ layered sand, cemented
 797 798 Clay, brown, medium, silty
 798 799 Clay, grey, fine, sandy-silty w/ layered sand, cemented, hard
 799 800 Clay, brown, silty, medium
 800 801 Sandy, grey, cemented
 801 806 Clay, grey, medium, silty
 806 808 Clay, brown, medium
 808 815 Clay, grey-brown, hard, sandy w/ layered sand, cemented
 815 818 Sand, grey, cemented & clay, grey, medium, sandy
 818 820 Clay, grey, medium, sandy w/ gravel, pea
 820 821 Clay, blue-grey, fine, sandy
 821 823 Clay, brown, medium w/ wood
 823 825 Clay, brown, medium & hard
 825 826 Clay, grey, sandy w/ sand, grey, cemented, hard & some gravel, p
 826 827 Wood
 827 828 Sand, grey, medium, cemented, hard w/ clay, white-tan & wood

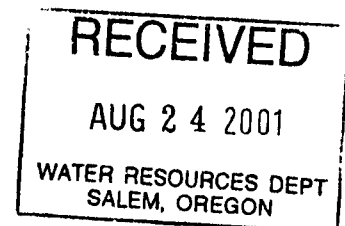


828 830 Clay, grey, soft to hard, silty
 830 834 Clay, brown, medium w/hard, silty & some wood
 834 835 Clay, grey, medium to soft
 835 836 Wood w/ clay, brown, medium
 836 841 Clay, brown, sandy, hard & soft
 841 842 Clay, tan, hard
 842 850 Clay, grey, medium-soft, silty w/claystone, grey
 850 861 Clay, blue-green, medium-hard, silty
 861 863 Clay, grey, medium-hard
 863 866 Clay, brown, medium
 866 871 Clay, blue-grey, medium, silty
 871 874 Sandy, grey, cemented w/clay, grey & some gravel, pea
 874 880 Clay, brown, medium, silty w/layers of sand, fine, cemented, hard
 880 890 Clay, brown-grey, med., silty w/ some gravel, pea & sand, cement
 890 894 Sand, medium, cemented, hard & gravel, pea
 894 895 Sand, medium, cemented, hard & gravel, pea w/ clay, brown, sand
 895 896 Clay, grey, medium
 896 899 Clay, grey, medium, sandy w/ layers of sand, grey, cemented
 899 916 Clay, blue-grey, medium-hard
 916 928 Clay, green-grey, sandy, hard-soft
 928 932 Clay, brown, medium, silty
 932 952 Clay, grey, sandy, layers, hard-soft w/wood
 952 958 Clay, blue-green, medium-hard
 958 959 Clay, green, medium-hard, silty
 959 961 Clay, grey, medium, silty
 961 967 Clay, grey-green, medium, silty
 967 968 Clay, blue-grey, hard
 968 969 Clay, green, sandy, fine
 969 970 Clay, brown, medium
 970 973 Clay, grey, medium
 973 974 Clay, blue-grey, medium
 974 982 Clay, grey & brown, medium
 982 989 Clay, grey, medium
 989 993 Clay, brown, silty
 993 1000 Gravel, black, 2"-, some cementation like in volcanic rock
 1000 1005 Clay, blue-grey, silty, soft & hard
 1005 1011 Clay, brown, silty
 1011 1016 Clay, grey, medium, silty
 1016 1018 Clay, green & grey, medium, silty
 1018 1022 Clay, brown, medium

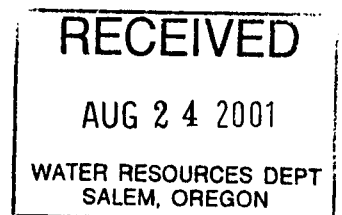

OREGON CITY SCHOOL DISTRICT MOSS CAMPUS WELL


Step Test - Drawdown after 2 hrs per step 8/1/01

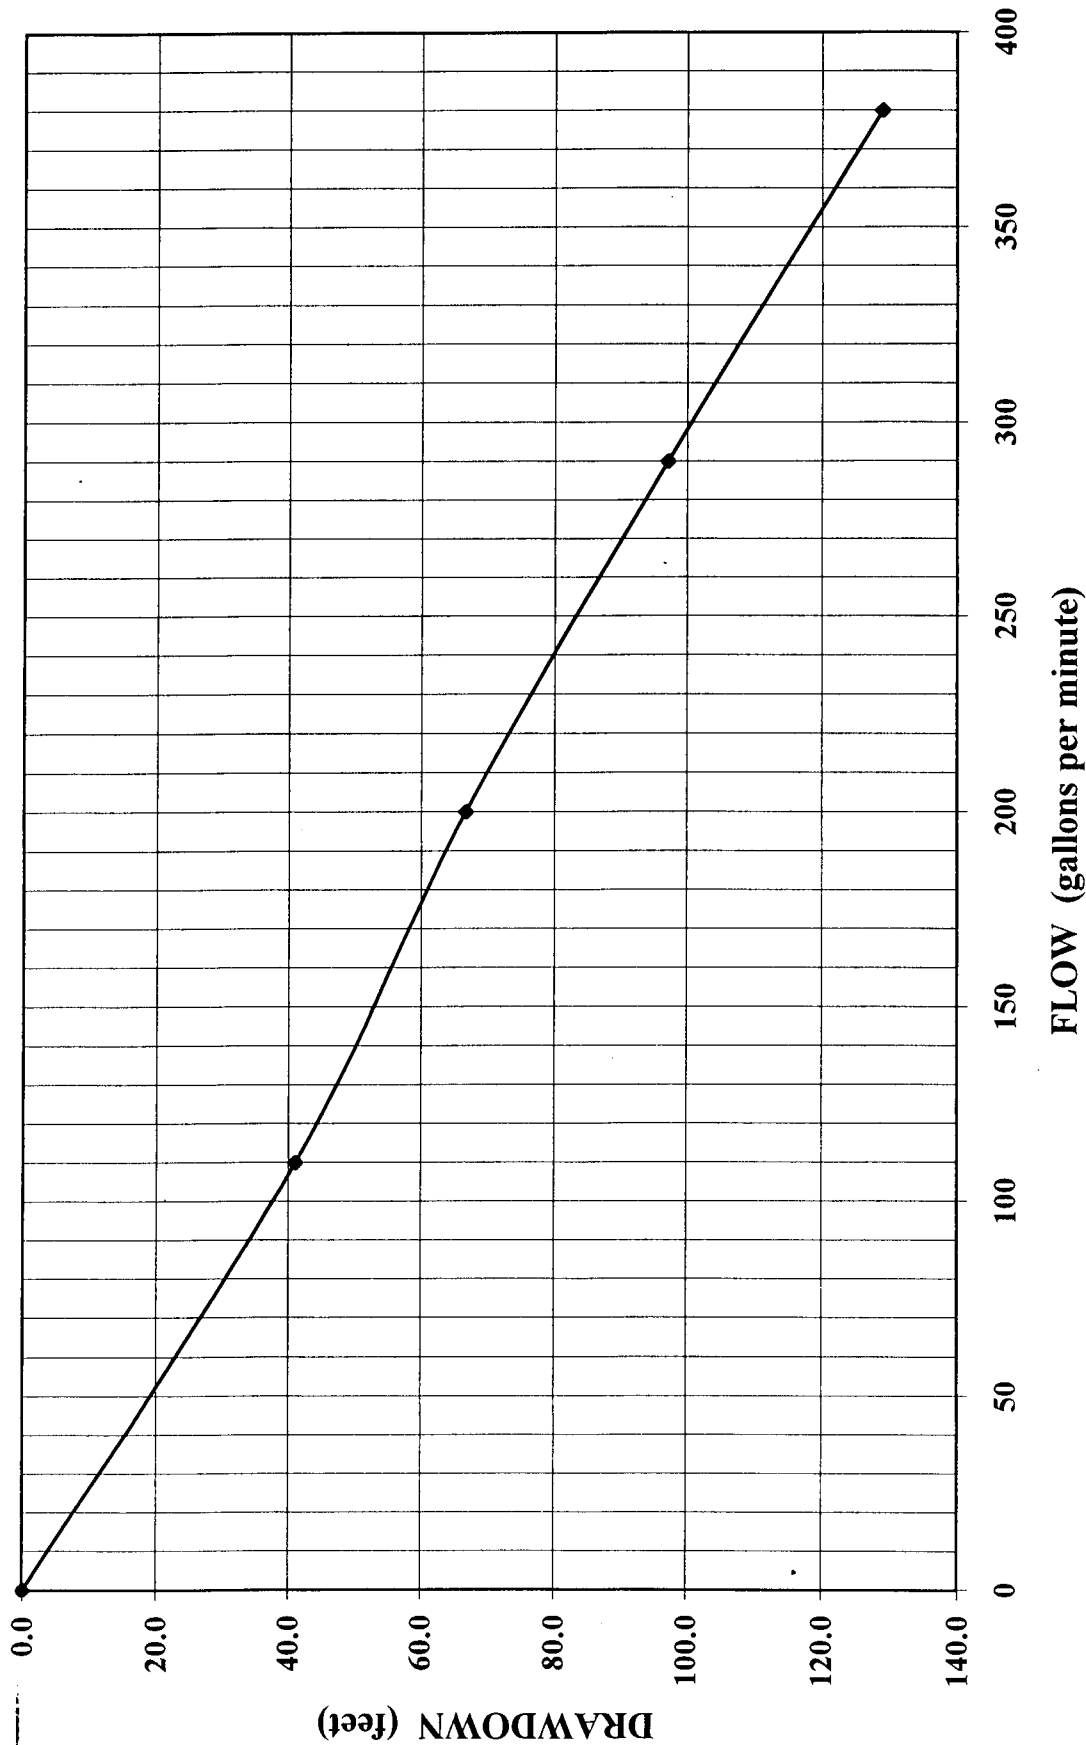

RECEIVED
AUG 24 2001
WATER RESOURCES DEPT
SALEM, OREGON

OREGON CITY SCHOOL DISTRICT MOSS CAMPUS WELL

Constant Rate Pumping Test Beginning 8/2/01

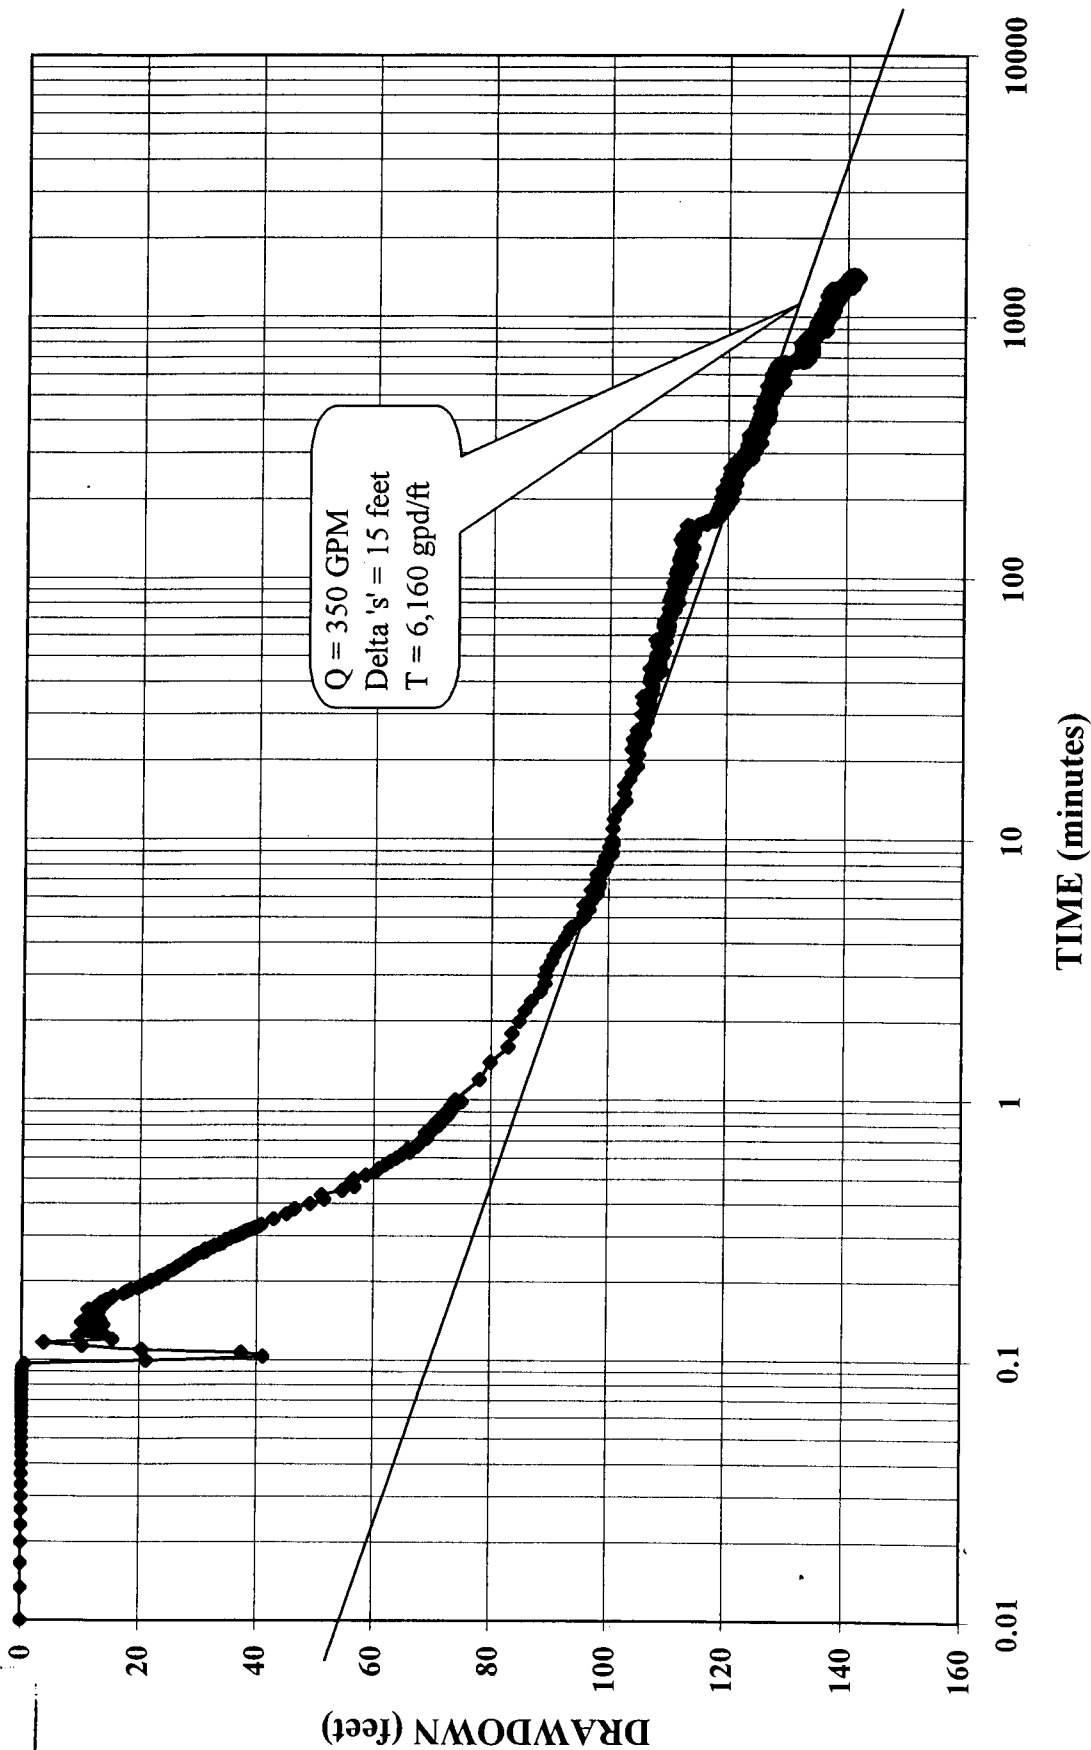

RECEIVED
AUG 24 2001
WATER RESOURCES DEPT
SALEM, OREGON

OREGON CITY SCHOOL DISTRICT MOSS CAMPUS WELL
Constant Rate Test Recovery Beginning 8/3/01

RECEIVED
AUG 24 2001
WATER RESOURCES DEPT
SALEM, OREGON

