

**STATE OF OREGON**  
**WATER SUPPLY WELL REPORT**  
 (as required by ORS 537.765)

WELL I.D. # L 56241  
 START CARD # 142696

Instructions for completing this report are on the last page of this form.

(1) **LAND OWNER** Well Number \_\_\_\_\_  
 Name DON CARPENTER  
 Address P.O. BOX 472  
 City CANBY State OR Zip 97013

(2) **TYPE OF WORK**  
 New Well  Deepening  Alteration (repair/recondition)  Abandonment

(3) **DRILL METHOD:**  
 Rotary Air  Rotary Mud  Cable  Auger  
 Other \_\_\_\_\_

(4) **PROPOSED USE:**  
 Domestic  Community  Industrial  Irrigation  
 Thermal  Injection  Livestock  Other \_\_\_\_\_

(5) **BORE HOLE CONSTRUCTION:**  
 Special Construction approval  Yes  No Depth of Completed Well 390 ft.  
 Explosives used  Yes  No Type \_\_\_\_\_ Amount \_\_\_\_\_

HOLE			SEAL			
Diameter	From	To	Material	From	To	Sacks or pounds
20	0	30	BENT.	0	19	46 SACKS
16	30	135	CEMENT	19	135	85 SACKS
12	135	439				

How was seal placed: Method  A  B  C  D  E  
 Other BENT. PLACED DRY  
 Backfill placed from 400 ft. to 439 ft. Material CEMENT GROUT  
 Gravel placed from 203 ft. to 400 ft. Size of gravel 6/9 & 8/12

(6) **CASING/LINER:**

Diameter	From	To	Gauge	Steel	Plastic	Welded	Threaded
Casing: 12	+1.5	230	.250	<input checked="" type="checkbox"/>	<input type="checkbox"/>	<input checked="" type="checkbox"/>	<input type="checkbox"/>
				<input type="checkbox"/>	<input type="checkbox"/>	<input type="checkbox"/>	<input type="checkbox"/>
				<input type="checkbox"/>	<input type="checkbox"/>	<input type="checkbox"/>	<input type="checkbox"/>
				<input type="checkbox"/>	<input type="checkbox"/>	<input type="checkbox"/>	<input type="checkbox"/>
Liner: 8"	202	390	.250	<input checked="" type="checkbox"/>	<input type="checkbox"/>	<input checked="" type="checkbox"/>	<input type="checkbox"/>
				<input type="checkbox"/>	<input type="checkbox"/>	<input type="checkbox"/>	<input type="checkbox"/>
				<input type="checkbox"/>	<input type="checkbox"/>	<input type="checkbox"/>	<input type="checkbox"/>

EXCEPT FOR SCREENS

Drive Shoe used  Inside  Outside  None  
 Final location of shoe(s) 230

(7) **PERFORATIONS/SCREENS:**

Perforations Method CONTINUOUS WRAP  
 Screens Type V WIRE Material SS

From	To	Slot size	Number	Diameter	Tele/pipe size	Casing	Liner
233' 6"	244'	.065		8"	P/s	<input type="checkbox"/>	<input type="checkbox"/>
248' 6"	256'	.065		8"	P/s	<input type="checkbox"/>	<input type="checkbox"/>
311'	316' 6"	.065		8"	P/s	<input type="checkbox"/>	<input type="checkbox"/>
335' 6"	346'	.065		8"	P/s	<input type="checkbox"/>	<input type="checkbox"/>
364' 6"	370' 050			8"	P/s	<input type="checkbox"/>	<input type="checkbox"/>

(8) **WELL TESTS:** Minimum testing time is 1 hour

<input checked="" type="checkbox"/> Pump	<input type="checkbox"/> Bailer	<input type="checkbox"/> Air	<input type="checkbox"/> Artesian
Yield gal/min	Drawdown	Drill stem at	Flowing Time
			1 hr.
250	210		8 1/2

Temperature of water 55 Depth Artesian Flow Found \_\_\_\_\_  
 Was a water analysis done?  Yes By whom \_\_\_\_\_  
 Did any strata contain water not suitable for intended use?  Too little  
 Salty  Muddy  Odor  Colored  Other \_\_\_\_\_  
 Depth of strata: \_\_\_\_\_

(9) **LOCATION OF WELL by legal description:**  
 County CLACKAMAS Latitude \_\_\_\_\_ Longitude \_\_\_\_\_  
 Township 4S N or S Range 1E E or W. WM.  
 Section 22 SW 1/4 NW 1/4  
 Tax Lot 1000 Lot \_\_\_\_\_ Block \_\_\_\_\_ Subdivision \_\_\_\_\_  
 Street Address of Well (or nearest address) NW CORNER OF GRIBBLE RD. & CANBY MARQUAM RD. INTERSECTION

(10) **STATIC WATER LEVEL:**  
 \_\_\_\_\_ ft. below land surface. Date 6-6-02  
 Artesian pressure \_\_\_\_\_ lb. per square inch Date \_\_\_\_\_

(11) **WATER BEARING ZONES:**  
 Depth at which water was first found 28

From	To	Estimated Flow Rate	SWL
ALL SAND LAYERS BELOW		186'	66

(12) **WELL LOG:**

Material	From	To	SWL
SEE ATTACHED			

**Westerberg Drilling, Inc.**  
**36728 S. Kropf Rd.**  
**Molalla, OR 97038**  
**RECEIVED**  
**JUN 24 2002**  
 WATER RESOURCES DEPT.  
 SALEM, OREGON

Date started 4-11-02 Completed 6-12-02

(unbonded) **Water Well Constructor Certification:**  
 I certify that the work I performed on the construction, alteration, or abandonment of this well is in compliance with Oregon water supply well construction standards. Materials used and information reported above are true to the best of my knowledge and belief.  
 WWC Number \_\_\_\_\_  
 Signed \_\_\_\_\_ Date \_\_\_\_\_

(bonded) **Water Well Constructor Certification:**  
 I accept responsibility for the construction, alteration, or abandonment work performed on this well during the construction dates reported above. All work performed during this time is in compliance with Oregon water supply well construction standards. This report is true to the best of my knowledge and belief.  
 WWC Number 688  
 Signed Steven M. Stahl Date 6-20-02

CLAC 57949


DON CARPENTER

P.O. BOX 472

CANBY, OR 97013

CLACKAMAS T4S R1E SEC 22 SW $\frac{1}{4}$  NW $\frac{1}{4}$  TAX LOT 1000

NW CORNER OF GRIBBLE RD. & CANBY MARQUAM RD. INTERSECTION

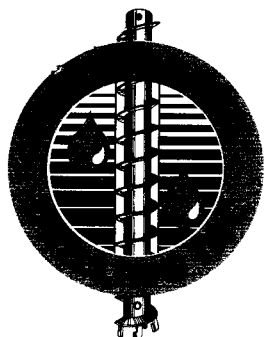

36728 S. Kropf Rd., Molalla, OR 97038 • Phone: (503) 829-2526 FAX (503) 829-7514

WELL LOG:

Material	From	To	
top soil	0	1	
clay brown	1	17	
clay grey silty	17	28	
cobbles with clay grey	28	41	
clay grey	41	53	
clay green	53	66	
clay grey	66	97	
sandy clay grey	97	101	
clay grey	101	123	
clay grey sandy	123	128	
clay grey	128	186	
sand grey cemented with few gravels	186	193	
clay greensticky	193	209	
clay with sand streaks	209	216	
clay grey	216	236	
sand dirty with some small pebbles & clay	236	243	10
clay blue	243	251	
clay grey with sand lenses	251	255	7
clay grey	255	314	
sand fine	314	316	5
clay green blue	316	339	
sand black coarse with fine gravel	339	346	10
clay green blue	346	367	
sandy grey clay fine	367	370	5
clay grey	370	399	
cemented sand with silt & some small gravel	399	436	
clay blue	436	439	

RECEIVED

JUN 24 2002

WATER RESOURCES DEPT.  
SALEM, OREGON