

STATE OF OREGON WATER SUPPLY WELL REPORT (as required by ORS 537.765)

Instructions for completing this report are on the last page of this form.

(WELL I.D.)# L 51290

(START CARD) # 143351

Clac 58216

(1) OWNER: Name J. Frank Schmidt & Son Co. Well Number BF #5

Address PO Box 189 City Boring State OR Zip 97009

(2) TYPE OF WORK

New Well Deepening Alteration (repair/recondition) Abandonment

(3) DRILL METHOD:

Rotary Air Rotary Mud Cable Auger Other Reverse Circulation Rotary

(4) PROPOSED USE:

Domestic Community Industrial Irrigation Thermal Injection Livestock Other

(5) BORE HOLE CONSTRUCTION:

Special Construction approval Yes No Depth of Completed Well 352 ft. Explosives used Yes No Type Amount

HOLE SEAL

Table with columns: Diameter, From, To, Material, Sacks or pounds. Rows for Bentonite and Cement.

How was seal placed: Method A B C D E

Other Bentonite was poured & probed

Backfill placed from ft. to ft. Material Gravel placed from 128 ft. to 365 ft. Size of gravel CSSI 8x12

(6) CASING/LINER:

Table with columns: Diameter, From, To, Gauge, Steel, Plastic, Welded, Threaded. Rows for Casing and Liner.

Final location of shoe(s) no shoe; has plate bottom

(7) PERFORATIONS/SCREENS:

Table with columns: From, To, Slot size, Number cont., Diameter, Tele/pipe size, Casing, Liner. Includes Perforations and Screens.

(8) WELL TESTS: Minimum testing time is 1 hour

Table for well tests with columns: Yield gal/min, Drawdown, Drill stem at, Time. Includes Pump, Bailer, Air, Flowing Artesian.

Temperature of water approx 55F Depth Artesian Flow Found Was a water analysis done? Did any strata contain water not suitable for intended use?

(9) LOCATION OF WELL by legal description:

County Clackamas Latitude Longitude Township 4 S Range 1 E WM. Section 19 NE 1/4 NW 1/4 Tax Lot 200 Lot Block Subdivision Street Address of Well (or nearest address) 27267 S. Barlow Rd Canby, OR 97013

(10) STATIC WATER LEVEL:

99 ft. below land surface. Date 7/31/02 Artesian pressure lb. per square inch. Date

(11) WATER BEARING ZONES:

Depth at which water was first found 71

Table with columns: From, To, Estimated Flow Rate, SWL. Rows for water levels and screened intervals.

(12) WELL LOG:

Table for well log with columns: Material, From, To, SWL. Includes 'RECEIVED' stamp and date SEP 25 2002.

Date started 4/3/02 Completed 7/31/02

(unbonded) Water Well Constructor Certification:

I certify that the work I performed on the construction, alteration, or abandonment of this well is in compliance with Oregon water supply well construction standards.

Signed Steve Villard WWC Number 1530 Date 9/20/02

(bonded) Water Well Constructor Certification:

I accept responsibility for the construction, alteration, or abandonment work performed on this well during the construction dates reported above.

Signed J. Frank Schmidt WWC Number 649 Date 9/20/02


J Frank Schmidt & Son Co. BF #5 Well

by Schneider Drilling Co.

Start Card #143351

Label #L51290


<u>FM</u>	<u>TO</u>	<u>DESCRIPTION</u>
0	1	Top soil, brown
1	3	Clay, light brown, firm
3	7	Clay, dark brown, soft
7	12	Clay, grey, silty
12	41	Clay, grey, sandy with sand lenses
41	51	Clay, grey, sticky
51	57	Sand, grey, medium
57	71	Clay, grey, soft
71	100	Gravel, 4"- & sand, grey, fine to coarse
100	112	Clay, grey & brown, sticky
112	116	Sand, dark grey, fine
116	118	Clay, grey, sticky
118	120	Clay, grey, soft with wood
120	126	Clay, green, sticky with clay, brown, sandy & some wood
126	135	Clay, grey, sandy
135	137	Sand, grey, clayey
137	139	Sand, grey, fine
139	153	Clay, grey, sticky
153	156	Sand, grey, medium
156	159	Clay, green & grey, hard, fractured
159	176	Clay, grey & green, sticky
176	181	Clay, green, sticky with some clay, green, hard
181	209	Clay, grey, sticky
209	218	Clay, grey, sandy with some pea gravel & sand, grey, fine
218	224	Clay, green, med, sticky
224	229	Clay, grey, med, sticky
229	231	Clay, grey & green, sticky with some sand, brown, cemented
231	234	Clay, brown, hard with clay, grey & green, soft
234	237	Clay, brown & grey, soft
237	246	Clay, brown, firm & clay, hard, brown
246	253	Clay, grey-soft & pea gravel & clay, hard, green, broken
253	255	Clay, green, firm & clay, grey, soft with wood
255	260	Clay, grey, sticky
260	270	Sand, grey, coarse
270	275	Clay, brown, sticky
275	297	Clay, grey-soft & clay, hard, firm, fractured
297	318	Clay, grey, sticky
318	326	Clay, grey, soft
326	348	Clay, blue & grey, soft, sandy & wood
348	360	Clay, grey, soft
360	365	Clay, grey & green, sticky

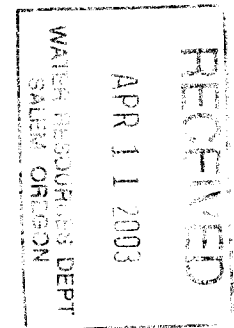

RECEIVED

SEP 25 2002

WATER RESOURCES DEPT.
SALEM, OREGON

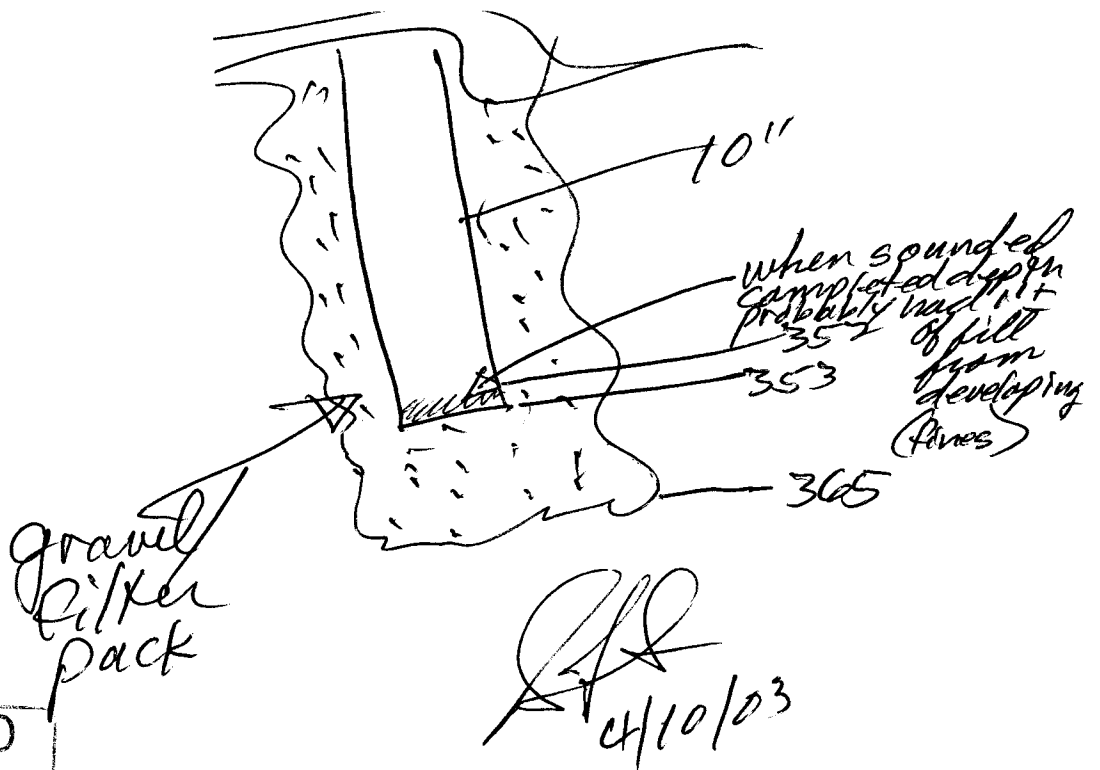

RECEIVED
APR 11 2003
WATER RESOURCES DEPT
SALEM, OREGON