

STATE OF OREGON

WELL ID # L 60152

WATER SUPPLY WELL REPORT

(as required by ORS 537.765)

Instructions for completing this report are on the last page of this form

SKYLES DRILLING, INC.

START CARD # W162324

(1) OWNER:

Well Number: 03

Name **Gordon Schoonover**Address **22322 S. Central Point Rd.**City **Oregon City** State **OR** Zip **97045**

(2) TYPE OF WORK:

☒ New Well ☐ Deepening ☐ Alteration (repair/recondition) ☐ Abandonment

(3) DRILL METHOD:

☒ Rotary Air ☐ Rotary Mud ☐ Cable ☐ Auger☒ Other **Holte**

(4) PROPOSED USE:

☒ Domestic ☐ Community ☐ Industrial ☐ Irrigation☐ Thermal ☐ Injection ☐ Livestock ☐ Other

(5) BORE HOLE CONSTRUCTION:

Special Construction approval ☐ Yes ☒ No Depth of Completed Well **241** ft.Explosives used ☐ Yes ☒ No Type _____ Amount _____

HOLE			SEAL			Amount	
Diameter	From	To	Material	From	To	sacks or pounds	
10	0	34	Bentonite	34	0	14 Sacks	
8	34	258	Cement	240	235	5 Sacks	

* How was seal placed: Method ☐ A ☒ B ☐ C ☐ D ☐ E☒ Other **Poured Bentonite / Pumped Cement**

Backfill placed from _____ ft. to _____ ft. Material _____

Gravel placed from **258** ft. to **241** ft. Size of gravel **3/8 pea 15sk**

(6) CASING/LINER:

	Diameter	From	To	Gauge	Steel	Plastic	Welded	Threaded
Casing:	6	+1.5	240	.250	<input checked="" type="checkbox"/>	<input type="checkbox"/>	<input checked="" type="checkbox"/>	<input type="checkbox"/>
					<input type="checkbox"/>	<input type="checkbox"/>	<input type="checkbox"/>	<input type="checkbox"/>
					<input type="checkbox"/>	<input type="checkbox"/>	<input type="checkbox"/>	<input type="checkbox"/>
					<input type="checkbox"/>	<input type="checkbox"/>	<input type="checkbox"/>	<input type="checkbox"/>
Liner:	None				<input type="checkbox"/>	<input type="checkbox"/>	<input type="checkbox"/>	<input type="checkbox"/>
					<input type="checkbox"/>	<input type="checkbox"/>	<input type="checkbox"/>	<input type="checkbox"/>

Drive Shoe used ☐ Inside ☐ Outside ☒ None

Final location of shoe(s) _____

(7) PERFORATIONS/SCREENS:

☐ Perforations

Method _____

☐ Screens

Type _____

Material _____

From	To	Slot size	Number	Diameter	Tele/pipe size	Casing	Liner
None						<input type="checkbox"/>	<input type="checkbox"/>
						<input type="checkbox"/>	<input type="checkbox"/>
						<input type="checkbox"/>	<input type="checkbox"/>
						<input type="checkbox"/>	<input type="checkbox"/>

(8) WELL TESTS: Minimum testing time is 1 hour

☐ Pump ☐ Bailer ☒ Air ☐ Flowing Artesian

Yield gal/min	Drawdown	Drill stem at	Time
25		238	1 hr.
25		218	15 min.

Temperature of Water **57** Depth Artesian Flow found _____Was a water analysis done? ☒ Yes By whom **Driller 0.10 PPM Iron**Did any Gr. contain water not suitable for intended use? ☐ Too littleSalty ☐ Muddy ☐ Odor ☐ Colored ☒ Other **High Iron**Depth of test: **111'-137'; 156'-163'; 211'-227'**

(9) LOCATION OF WELL by legal description:

County **Clackamas** Latitude _____ Longitude _____Township **3SOUTH** N or S. Range **1EAST** E or W. of WM.Section **25** SW 1/4 NE 1/4Tax lot **00300** Lot _____ Block _____ Subdivision _____Street Address of Well (or nearest address) **22322 S. Central Point****Rd., Oregon City, OR**

(10) STATIC WATER LEVEL:

78 ft. below land surface.Date **11/24/2003**

Artesian pressure _____ lb. per square inch.

Date _____

(11) WATER BEARING ZONES:

Depth at which water was first found **56'**

From	To	Estimated Flow Rate	SWL
56/111	61/137	3/10	52
156	163	30	117
211	227	10	84
247	257	75	78

(12) WELL LOG:

Ground elevation _____

Material	From	To	SWL
Top Soil, Brown	0	3	
Clay, Brown, Sandy	3	27	
Clay, Gray & Tan	27	56	
Cemented Sand, Brown, Fine	56	61	
Clay, Blueish-Gray	61	107	
Clay, Gray, Very Sandy	107	111	
Cemented Sand w/ Sand, Coarse & Gravel, Small	111	118	
Clay, Gray, Very Sandy w/ Seams of Sand and Wood	118	156	
Sand, Gray, Medium to Fine	156	163	
Clay, Gray, Sandy	165	184	
Clay, Greenish-Blue	184	195	
Clay, Gray	195	209	
Wood, Brown	209	211	
Clay Gray & Blue, Very Sandy w/ Cemented Sand, Gray & Wood	211	227	
Clay, Greenish-Gray, Sandy	227	247	
Cemented Sand, Multicolored & Wood w/ Lens of Clay, Gray	247	257	78
Clay, Gray	257	258	

Skyles Drilling, Inc.
1100 Molalla Ave.
Oregon City, OR 97045
656-2683

Date started **11/18/2003** Completed **11/24/2003**

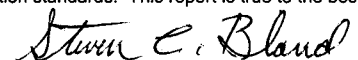
(unbonded) Water Well Constructor Certification:

I certify that the work I performed on the construction, alteration, or abandonment of this well is in compliance with Oregon water supply well construction standards. Materials used and information reported above are true to the best of my knowledge and belief.

Signed  WWC Number **1715**
 Date **12-1-03**

(bonded) Water Well Constructor Certification:

I accept responsibility for the construction, alteration, or abandonment work performed on this well during the construction dates reported above. All work performed during this time is in compliance with Oregon water supply well construction standards. This report is true to the best of my knowledge and belief.

Signed  WWC Number **1592**
 Date **12-1-03**

ORIGINAL WATER RESOURCES DEPARTMENT

FIRST COPY - CONSTRUCTOR

SECOND COPY - CUSTOMER

RECEIVED
NOV 26 2003