

STATE OF OREGON
WATER SUPPLY WELL REPORT
 (as required by ORS 537.765)

(WELL I.D.)# L 10395
 (START CARD) # 165527

Instructions for completing this report are on the last page of this form.

CLAC 60025

(1) OWNER: Well Number _____
 Name Reardon Nursery
 Address 10050 SE 282nd
 City Boring State OR Zip 97009

(2) TYPE OF WORK
 New Well Deepening Alteration (repair/recondition) Abandonment

(3) DRILL METHOD:
 Rotary Air Rotary Mud Cable Auger
 Other

(4) PROPOSED USE:
 Domestic Community Industrial Irrigation
 Thermal Injection Livestock Other

(5) BORE HOLE CONSTRUCTION:
 Special Construction approval Yes No Depth of Completed Well 420 ft.
 Explosives used Yes No Type _____ Amount _____

HOLE			SEAL			Sacks or pounds
Diameter	From	To	Material	From	To	
6"	400	420	seal not disturb			

How was seal placed: Method A B C D E
 Other _____
 Backfill placed from _____ ft. to _____ ft. Material _____
 Gravel placed from _____ ft. to _____ ft. Size of gravel _____

(6) CASING/LINER:

Diameter	From	To	Gauge	Steel	Plastic	Welded	Threaded
Casing:				<input type="checkbox"/>	<input type="checkbox"/>	<input type="checkbox"/>	<input type="checkbox"/>
Liner:				<input type="checkbox"/>	<input type="checkbox"/>	<input type="checkbox"/>	<input type="checkbox"/>

Final location of shoe(s) _____

(7) PERFORATIONS/SCREENS:

From	To	Slot size	Number	Diameter	Material	Tele/pipe size	Casing	Liner
							<input type="checkbox"/>	<input type="checkbox"/>

(8) WELL TESTS: Minimum testing time is 1 hour

Yield gal/min	Drawdown	Drill stem at	Time
400		420	1 hr.

Temperature of water 56 Depth Artesian Flow Found _____
 Was a water analysis done? Yes By whom _____
 Did any strata contain water not suitable for intended use? Too little
 Salty Muddy Odor Colored Other _____
 Depth of strata: _____

(9) LOCATION OF WELL by legal description:
 County Clackamas Latitude _____ Longitude _____
 Township 1 S Range 4E W WM. _____
 Section 31 NW 1/4 NW 1/4
 Tax Lot 600 Lot _____ Block _____ Subdivision _____
 Street Address of Well (or nearest address) 10570 SE 282nd Boring



(10) STATIC WATER LEVEL:
150 ft. below land surface. 4-15-04 & original Date 4-17-1997
 Artesian pressure _____ lb. per square inch. Date _____

(11) WATER BEARING ZONES:
 Depth at which water was first found 150'

From	To	Estimated Flow Rate	SWL
original water only		400gpm	150

(12) WELL LOG:
 Ground Elevation _____

Material	From	To	SWL
Gray cemented gravel	400	420	150

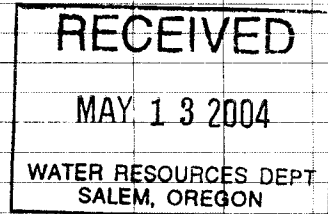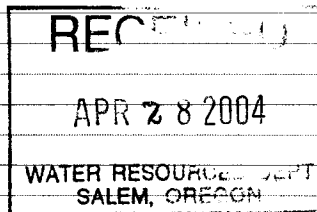

Date started 4/15/04 Completed 4/15/04

(unbonded) Water Well Constructor Certification:
 I certify that the work I performed on the construction, alteration, or abandonment of this well is in compliance with Oregon water supply well construction standards. Materials used and information reported above are true to the best of my knowledge and belief.

Signed Bob Erler WWC Number 663
 Date 4/19/04

(bonded) Water Well Constructor Certification:
 I accept responsibility for the construction, alteration, or abandonment work performed on this well during the construction dates reported above. All work performed during this time is in compliance with Oregon water supply well construction standards. This report is true to the best of my knowledge and belief.

Signed [Signature] WWC Number 1541
 Date 4/19/04