

**STATE OF OREGON
WATER SUPPLY WELL REPORT**

(as required by ORS 537.765)

Instructions for completing this report are on the last page of this form.

WELL I.D. # L 56656
START CARD # 163472

(1) OWNER: Eleanore Boekman Well Number _____
Name _____
Address 21210 NE Main St. NE
City Aurora State OR Zip 97002

(2) TYPE OF WORK
 New Well Deepening Alteration (repair/recondition) Abandonment

(3) DRILL METHOD:
 Rotary Air Rotary Mud Cable Auger
 Other _____

(4) PROPOSED USE:
 Domestic Community Industrial Irrigation
 Thermal Injection Livestock Other _____

(5) BORE HOLE CONSTRUCTION:
Special Construction approval Yes No Depth of Completed Well 224 ft.
Explosives used Yes No Type _____ Amount _____

HOLE			SEAL			Sacks or pounds
Diameter	From	To	Material	From	To	
12"	0	224	cement	0	148	84 cement 5% bentonite

How was seal placed: Method A B C D E
 Other _____
Backfill placed from _____ ft. to _____ ft. Material _____
Gravel placed from 148 ft. to 224 ft. Size of gravel 5-10

(6) CASING/LINER:

Diameter	From	To	Gauge	Steel	Plastic	Welded	Threaded
8"	0	224	2x2x2x2	<input type="checkbox"/>	<input type="checkbox"/>	<input type="checkbox"/>	<input type="checkbox"/>
2"	+19"	212		<input checked="" type="checkbox"/>	<input type="checkbox"/>	<input type="checkbox"/>	<input checked="" type="checkbox"/>
For gravel feed							
Liner:				<input type="checkbox"/>	<input type="checkbox"/>	<input type="checkbox"/>	<input type="checkbox"/>

Final location of shoe(s) _____

(7) PERFORATIONS/SCREENS:

Perforations Method _____
 Screens Type _____ Material stainless

From	To	Slot size	Number	Diameter	Tele/pipe size	Casing	Liner
163	169	075		8"	p.s. pipe	<input type="checkbox"/>	<input type="checkbox"/>
169	183			8"	pipe	<input checked="" type="checkbox"/>	<input type="checkbox"/>
183	192	075		8"	p.s. pipe	<input type="checkbox"/>	<input type="checkbox"/>
192	206			8"	pipe	<input checked="" type="checkbox"/>	<input type="checkbox"/>
206	212	075		8"	p.s. pipe	<input type="checkbox"/>	<input type="checkbox"/>

(8) WELL TESTS: Minimum testing time is 1 hour

212 224 8" pipe Flowing Artesian

Pump Bailer Air

Yield gal/min	Drawdown	Drill stem at	Time
55			1 hr.

Temperature of water 54 Depth Artesian Flow Found _____
Was a water analysis done? Yes By whom _____
Did any strata contain water not suitable for intended use? Too little
 Salty Muddy Odor Colored Other _____
Depth of strata: _____

(9) LOCATION OF WELL by legal description:
County Clackamas Latitude _____ Longitude _____
Township 5S N or S Range 1E E or W. WM.
Section 17 SE 1/4 NW 1/4
Tax Lot 0020Q of _____ Block _____ Subdivision _____
Street Address of Well (or nearest address) 6901 S. Schneider Rd.
Canby, OR 97013

(10) STATIC WATER LEVEL:
_____ ft. below land surface. Date 4/16/04
Artesian pressure _____ lb. per square inch. Date _____

(11) WATER BEARING ZONES:
Depth at which water was first found 90

From	To	Estimated Flow Rate	SWL
90	96	15 gpm	65
121	135	15 gpm	34
163	192	55 gpm	39

(12) WELL LOG:
Ground Elevation _____

Material	From	To	SWL
See attached log			

RECEIVED
JUL 20 2004
WATER RESOURCES DEPT
SALEM, OREGON

Date started 12/26/03 Completed 6/21/04
(unbonded) Water Well Constructor Certification:
I certify that the work I performed on the construction, alteration, or abandonment of this well is in compliance with Oregon water supply well construction standards. Materials used and information reported above are true to the best of my knowledge and belief.
Signed [Signature] WWC Number 1704 Date 7/14/04

(bonded) Water Well Constructor Certification:
I accept responsibility for the construction, alteration, or abandonment work performed on this well during the construction dates reported above. All work performed during this time is in compliance with Oregon water supply well construction standards. This report is true to the best of my knowledge and belief.
Signed [Signature] WWC Number 783 Date 7/14/04

Eleanore Boeckman
21210 NE Main St.
Aurora, OR 97002


Well I.D.# L56656

Start Card # 163472

Clackamas County Township: 5S Range: 1E Sec: 17 SE1/4, NW1/4
6901 S. Schneider Rd. Canby, OR 97013

WELL LOG

Material	From	To	SWL
Top soil	0	2	
Clay brown	2	8	
Clay brown & fine sand	8	27	
Clay gray, some fine sand	27	39	
Clay blue	39	46	
Clay rusty-tan	46	52	
Clay blue sandy	52	58	
Sand brown, gravel & clay	58	62	17'
Clay tan sandy	62	64	
Clay blue sandy	64	66	
Clay green & brown sandy	66	77	
Clay blue sticky	77	82	
Clay green sandy	82	85	
Claystone gray	85	88	65'
Clay yellow sticky	88	90	
Cemented sand brown	90	96	65'
Clay blue sticky	96	101	
Claystone green, sand	101	104	35
Clay green gritty	104	105	
Clay gray sticky	105	117	
Clay gray gritty	117	119	
Clay sandy green	119	121	
Sand black	121	135	34'
Clay blue sticky	135	137	
Clay blue & gray sticky	137	143	
Clay gray sticky	143	148	
Clay green	148	157	
Clay gray sticky	157	161	
Clay green gritty, some fine sand	161	164	
Sand black fine	164	170	41'
Clay blue sticky	170	179	
Clay gray	179	183	
Clay gray silty	183	184	
Clay sandy gray, w/seams of sand	184	188	41'

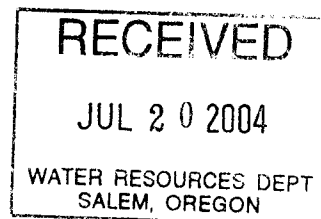

Clay white sticky	188	189	
Clay brown sandy w/ sand seams	189	193	41'
Clay brown silty	193	203	
Clay brown sandy	203	207	
Sand brown fine, silt & clay	207	213	41'
Clay brown silty	213	217	
clay gray	217	225	

RECEIVED

JUL 20 2004

WATER RESOURCES DEPT
SALEM, OREGON