

STATE OF OREGON
 WATER SUPPLY WELL REPORT
 (as required by ORS 537.765)

Westerberg Drilling, Inc.
36728 S. Kropf Rd.
Molalla, OR 97038

WELL I.D. # L 78667

START CARD # 182474

Instructions for completing this report are on the last page of this form.

(1) LAND OWNER Well Number _____
 Name Russell's Nursery Inc.
 Address 22241 Boones Ferry Rd. NE
 City Aurora State OR Zip 97002

(2) TYPE OF WORK New Well
 Deepening Alteration (repair/recondition) Abandonment Conversion

(3) DRILL METHOD
 Rotary Air Rotary Mud Cable Auger Cable Mud
 Other _____

(4) PROPOSED USE
 Domestic Community Industrial Irrigation
 Thermal Injection Livestock Other _____

(5) BORE HOLE CONSTRUCTION Special Construction: Yes No
 Depth of Completed Well 124 ft.
 Explosives used: Yes No Type _____ Amount _____

BORE HOLE			SEAL			
Diameter	From	To	Material	From	To	Sacks or Pounds
22"	0	20	Bentonite	0	12	28 sacks
			Cement	12	20	45 sacks
	See orig well report		Clac 08578			

How was seal placed: Method A B C D E
 Other Bentonite poured & probed in dry annulus

Backfill placed from 124 ft. to 125 ft. Material cement
 Gravel placed from 125 ft. to 126 ft. Size of gravel pea

(6) CASING/LINER

Diameter	From	To	Gauge	Steel	Plastic	Welded	Threaded
Casing: original				<input type="checkbox"/>	<input type="checkbox"/>	<input type="checkbox"/>	<input type="checkbox"/>
See well report	Clac	08578		<input type="checkbox"/>	<input type="checkbox"/>	<input type="checkbox"/>	<input type="checkbox"/>
Liner:				<input type="checkbox"/>	<input type="checkbox"/>	<input type="checkbox"/>	<input type="checkbox"/>

Drive Shoe used Inside Outside None
 Final location of shoe(s) _____

(7) PERFORATIONS/SCREENS
 Perforations Method Original
 Screens Type _____ Material _____

From	To	Slot Size	Number	Diameter	Tele/pipe size	Casing	Liner
						<input type="checkbox"/>	<input type="checkbox"/>
						<input type="checkbox"/>	<input type="checkbox"/>
						<input type="checkbox"/>	<input type="checkbox"/>
						<input type="checkbox"/>	<input type="checkbox"/>

(8) WELL TESTS: Minimum testing time is 1 hour
 Pump Bailer Air Flowing Artesian

Yield gal/min	Drawdown	Drill stem at	Time
No yield test	performed		

Temperature of water N/A Depth Artesian Flow Found _____
 Was a water analysis done? Yes By whom _____
 Did any strata contain water not suitable for intended use? Too little
 Salty Muddy Odor Colored Other _____
 Depth of strata: _____

(9) LOCATION OF WELL (legal description)
 County Clackamas
 Tax Lot 1000 Lot _____
 Township 3 S Range 1 W WM
 Section 25 SW 1/4 SW 1/4

Lat _____ " or _____ (degrees or decimal)
 Long _____ " or _____ (degrees or decimal)

Street Address of Well (or nearest address) 24766 NE Airport Rd.
Aurora, OR 97002


(10) STATIC WATER LEVEL
38 ft. below land surface. Date 11-17-05
 _____ ft. below land surface. Date _____
 Artesian pressure _____ lb. per square inch Date _____

(11) WATER BEARING ZONES
 Depth at which water was first found Original

From	To	Estimated Flow Rate	SWL
Original			
See well report	Clac 08578		

(12) WELL LOG Ground Elevation _____

Material	From	To	SWL
Overdrilled existing 12" casing w/ 22" washover tool to 20'. Pumped in 45 sacks cement, let set overnight. Topped off w/ 3/8" bentonite chips in dry annulus.			
We cleaned out well to 127' and it started to make a large volume of fine sand. We installed a cement/gravel plug in bottom to shut off sand.			

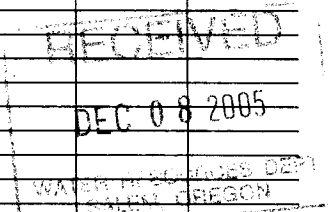

Date Started 11-17-05 Completed 11-18-05

(unbonded) Water Well Constructor Certification
 I certify that the work I performed on the construction, deepening, alteration, or abandonment of this well is in compliance with Oregon water supply well construction standards. Materials used and information reported above are true to the best of my knowledge and belief.

WWC Number 1358 Date 12-5-05
 Signed [Signature]

(bonded) Water Well Constructor Certification
 I accept responsibility for the construction, deepening, alteration, or abandonment work performed on this well during the construction dates reported above. All work performed during this time is in compliance with Oregon water supply well construction standards. This report is true to the best of my knowledge and belief.

WWC Number 688 Date 12-5-05
 Signed [Signature]